



# T.2N. R.11E. W.M.

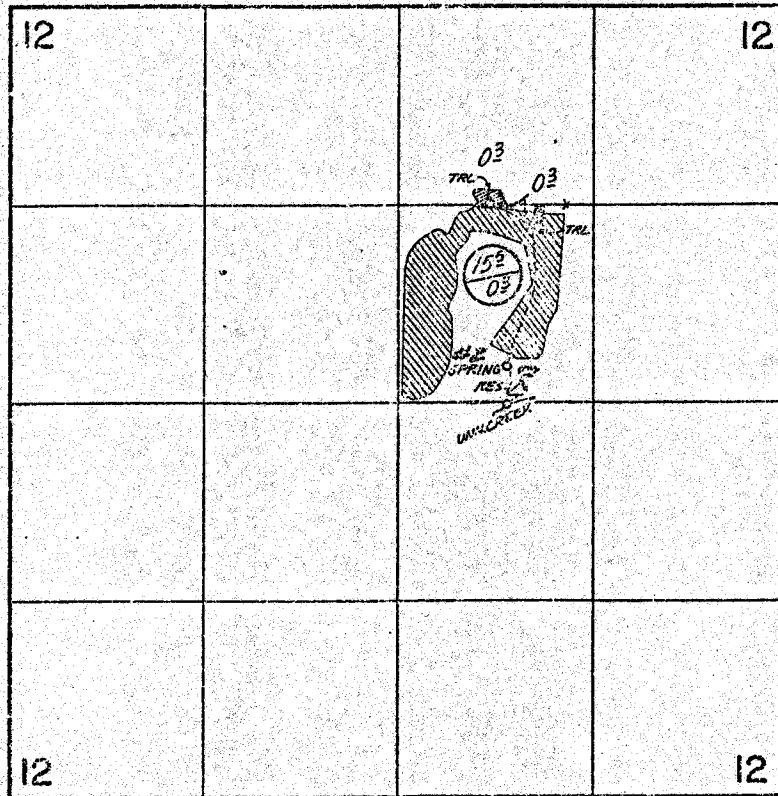

W.M. SPRING 240' N. & 720' E., W.M. CREEK 10' S. & 730' E., RES. 100' N. & 880' E.  
ALL FROM CENTER SECTION 12

W.M. SPRING, W.M. CREEK & RESERVOIR  W.M. SPRING 

 PRIMARY  
SUPPLEMENTAL

## FINAL PROOF SURVEY UNDER

R51810 R6111  
Application No. 51478 Permit No. 37763  
IN NAME OF  
EARL L. HOWARD

Surveyed JULY 17, 1975, by T. PAUL