


T.19S.,R.6W.,W.M.

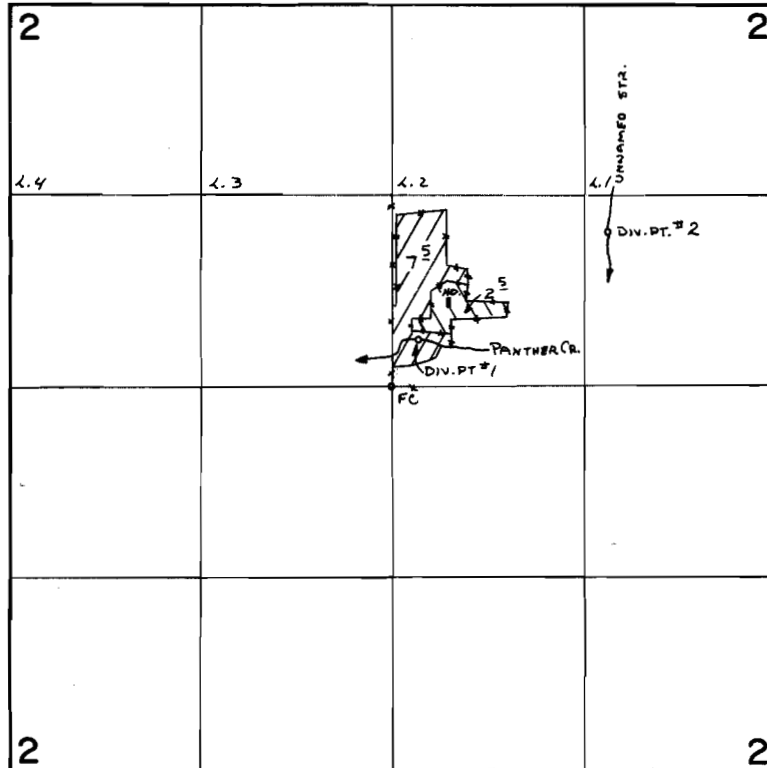

Panther Cr. #1 - 320' N AND 180' E } FROM CENTER SEC 2
Unn. Str. #2 - 1050' N AND 1400' E }



- FROM PANTHER CREEK ONLY
- FROM BOTH SOURCES

FINAL PROOF SURVEY UNDER

Application No. 43918 Permit No. 32823
IN NAME OF

JAMES W. HOOKER

Surveyed SEP. 17 1975, by L. T. H.