


44525

T.12S.,R.21E.,W.M.

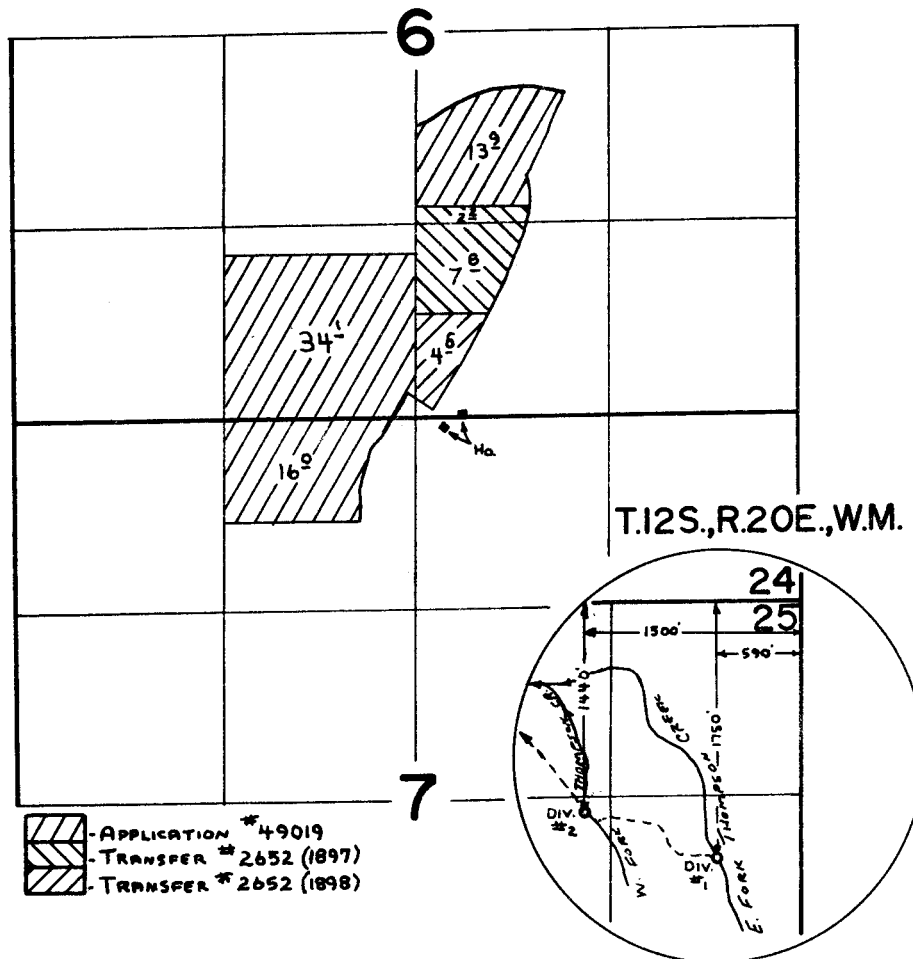

FINAL PROOF SURVEY
UNDER

Transfer No. 2652
Application No. 49019 Permit No. 36690
IN NAME OF

MAXWELL BROTHERS

Surveyed Aug 9 1974, by L. H. NUNN
JUNE 4 1975 L. Toll