


T.4 S. R.6 W. W.M.

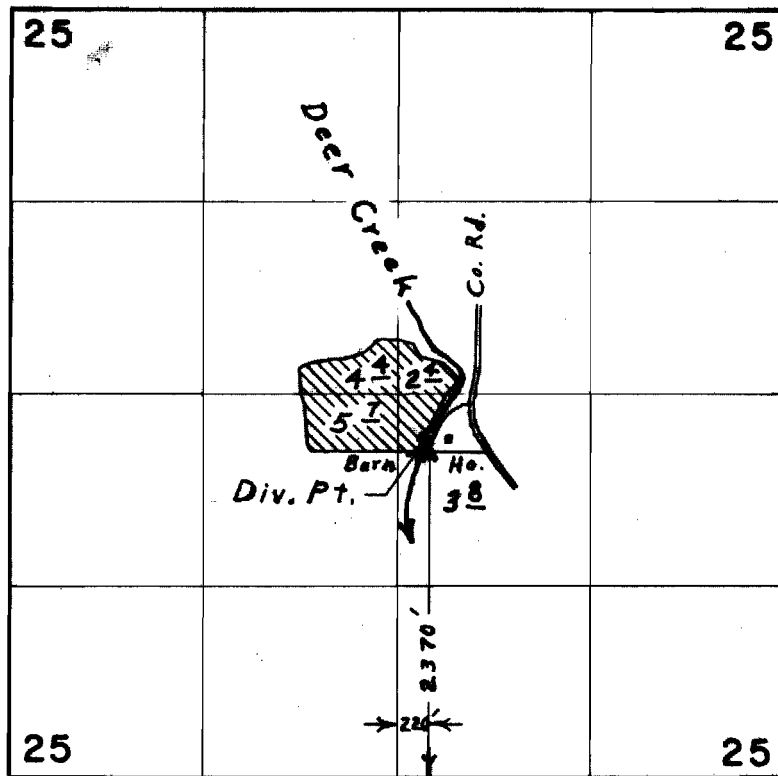

FINAL PROOF SURVEY
UNDER

Application No. 47147 Permit No. 35299
IN NAME OF

DONALD E. THOMAS

Surveyed Aug. 8, 1973, by L. E. Gould