


T. 4 S. R. 5 W. W.M.

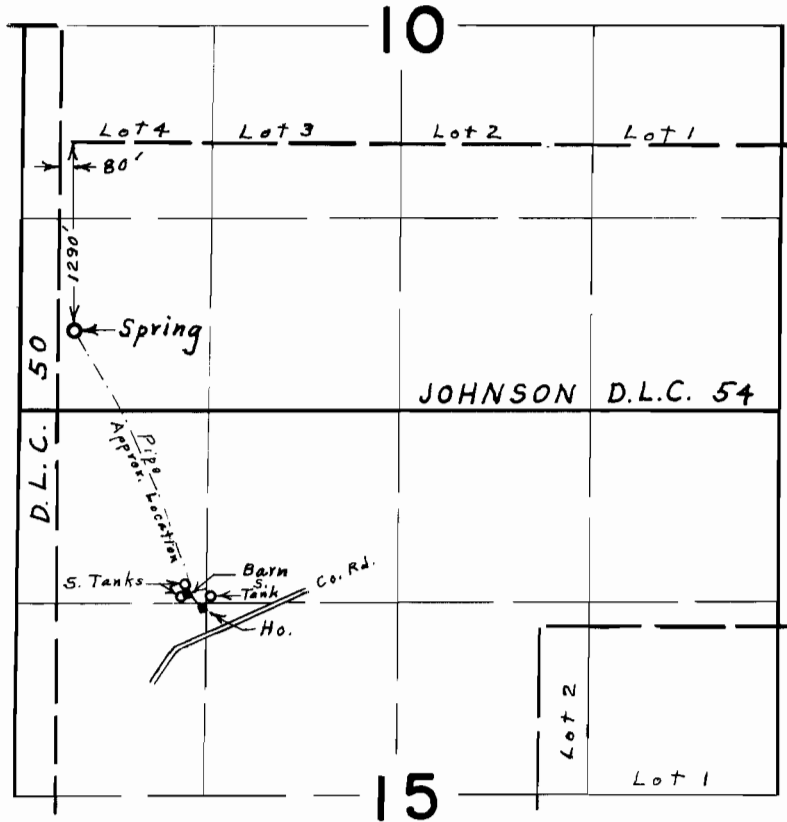

FINAL PROOF SURVEY  
UNDER

Application No. 51176.. Permit No. 37391..  
IN NAME OF  
GLENN H. EAGON

Surveyed April 18, 1975, by L. E. Gould