


T.3 S. R.5 W. W.M.

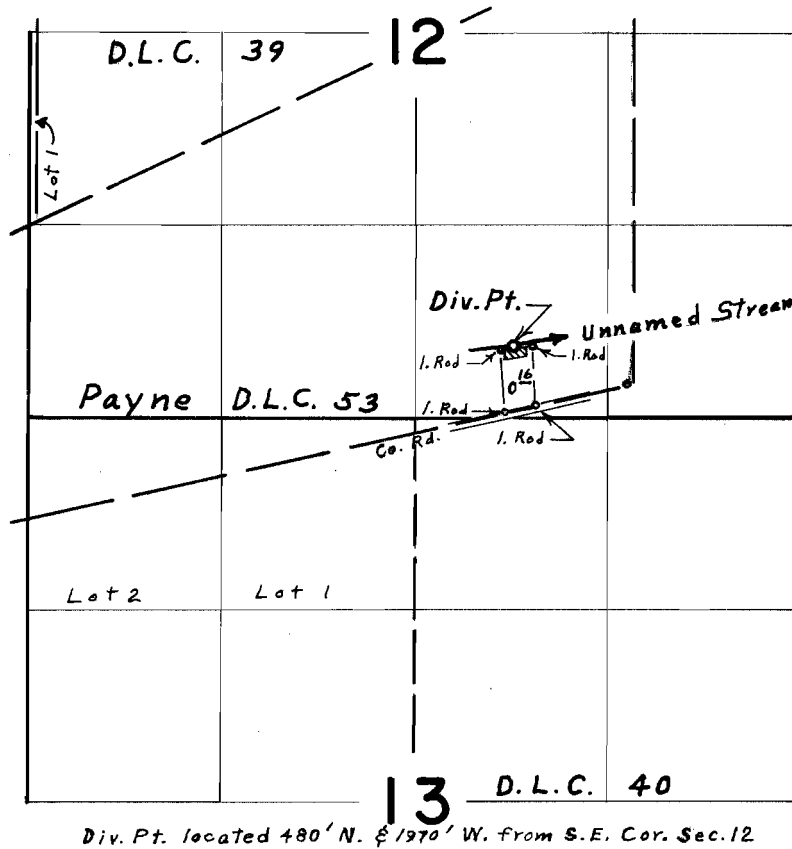

FINAL PROOF SURVEY
UNDER

Application No. 50120 Permit No. 37662
IN NAME OF

FRANK WIBKING

Surveyed Aug. 5, 1975, by W. E. Gould