


T.15S., R.5W., W.M.

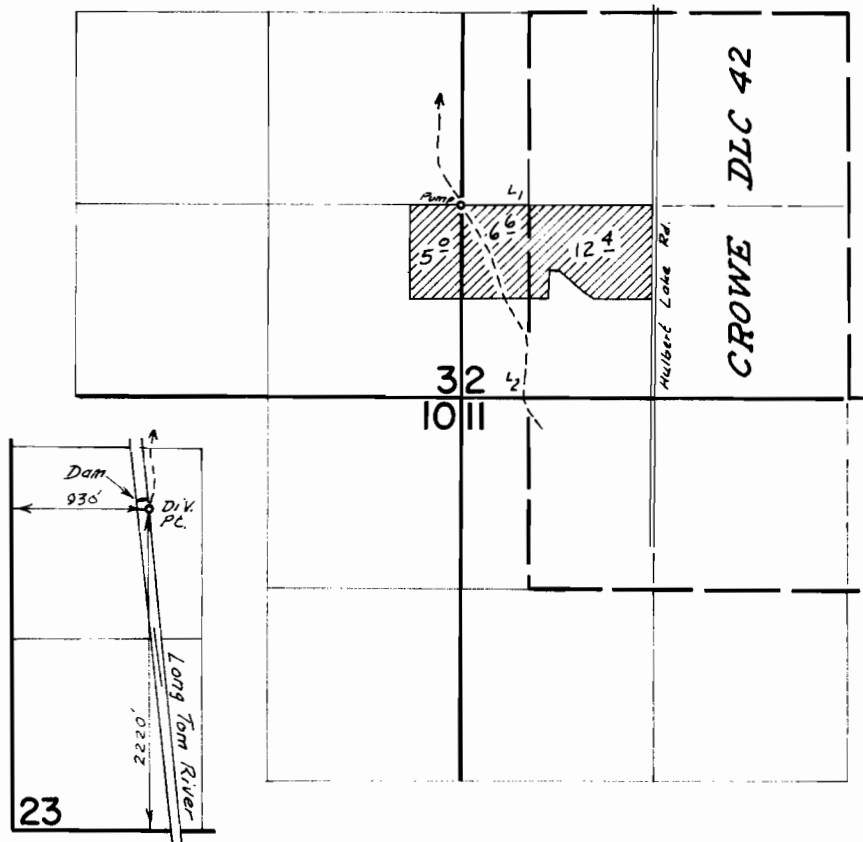

FINAL PROOF SURVEY
UNDER

Application No. 44809 Permit No. 33515
IN NAME OF

B. J. BROWN

Surveyed April 23 1975, by D. Norby