


T.3 S. R.7 E. W.M.

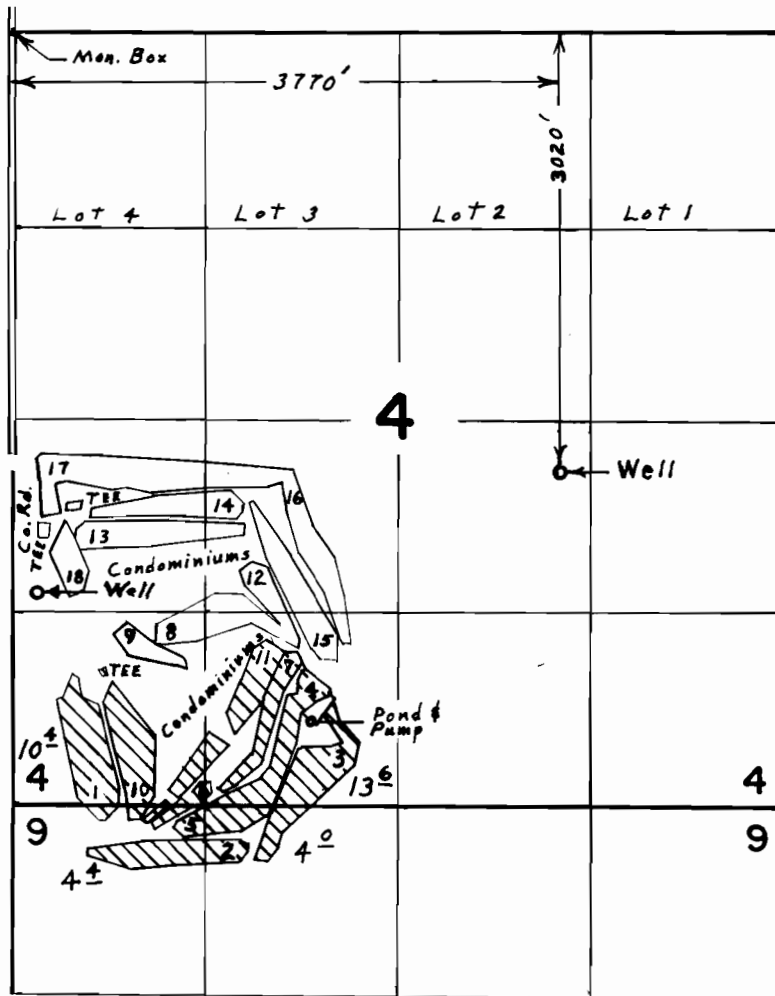

FINAL PROOF SURVEY UNDER

Application No. G-3959 Permit No. G-3713
IN NAME OF

SALMON VALLEY WATER COMPANY

Surveyed Oct. 12, 1976, by L. E. Gould