


T. 3 N., R. 2 W., W.M.

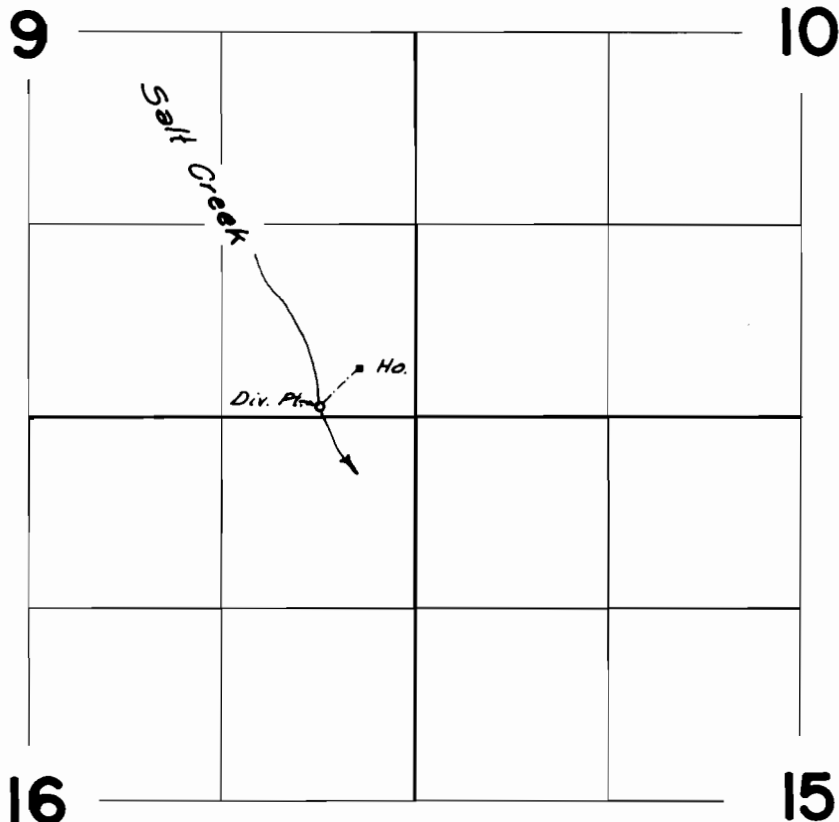

Div. Pt. Loc.: 70 ft. N. & 660 ft. W. from SE Cor. Sec. 9

FINAL PROOF SURVEY
UNDER

Application No. 47909 Permit No. 35899
IN NAME OF

Dale L. & Mary E. Peck

Surveyed May 25, 1976, by L. H. Nunn

PTS-1976-P *dlB*