


T. 28 S. R. 14 W. W. M

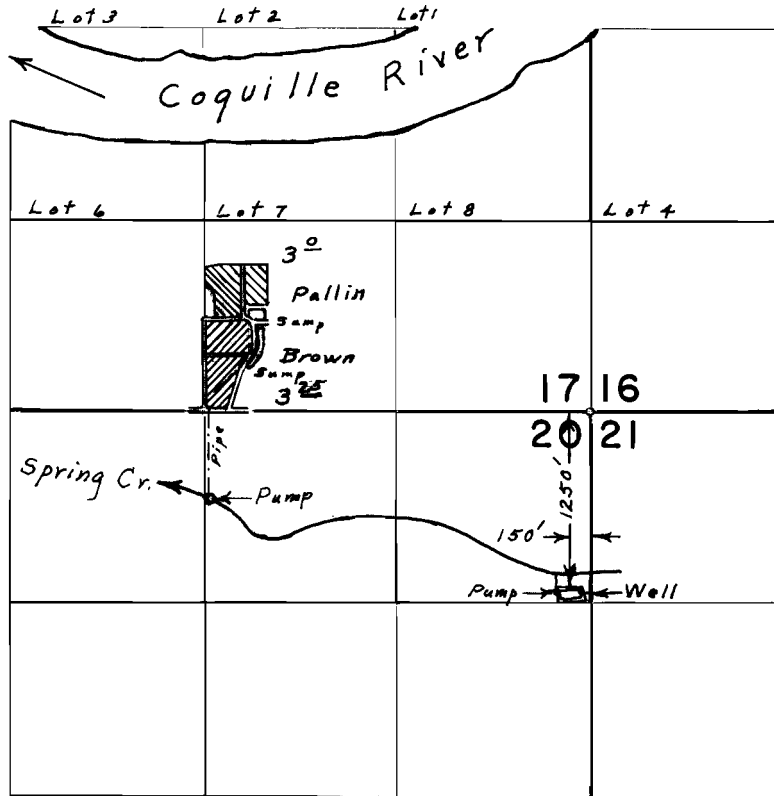

FINAL PROOF SURVEY UNDER

Application No. G-5343 Permit No. G-4912
IN NAME OF

LOUIS PALLIN & A. BROWN

Surveyed April 11, 1972, by L. E. Gould