


T.23S.,R.13W.,W.M.

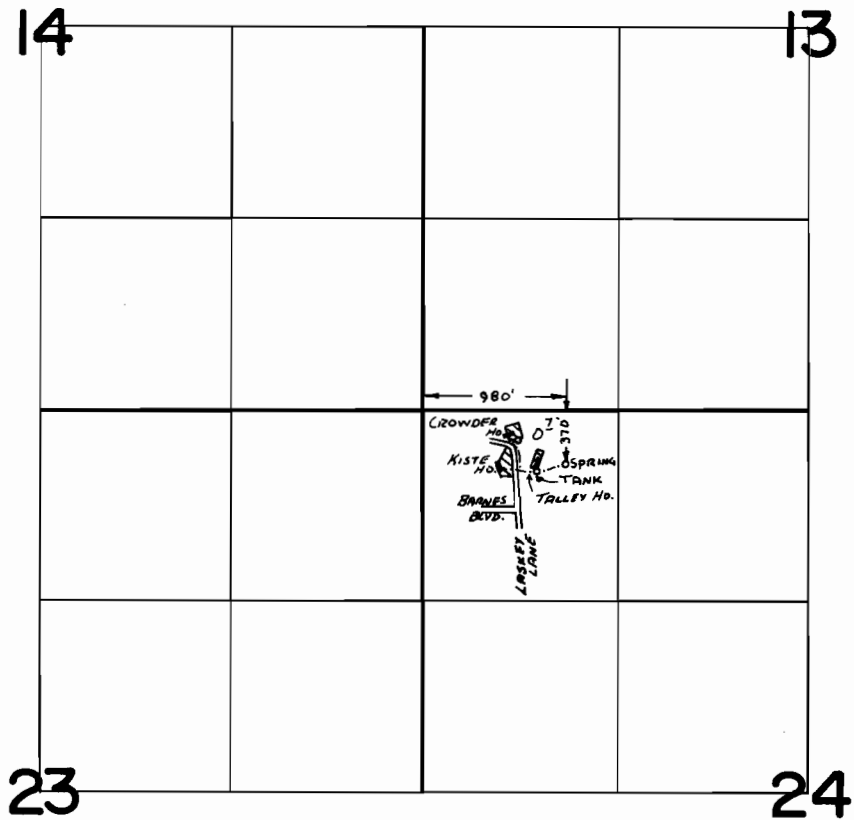

FINAL PROOF SURVEY
UNDER

Application No. .52412... Permit No. .37534..
IN NAME OF

..FLOYD.....BURL.....TALLEY,.....ET.....AL.

Surveyed *May 27* 1976, by *L. TOLL*.....