


Township 40 South, Range 14 West.

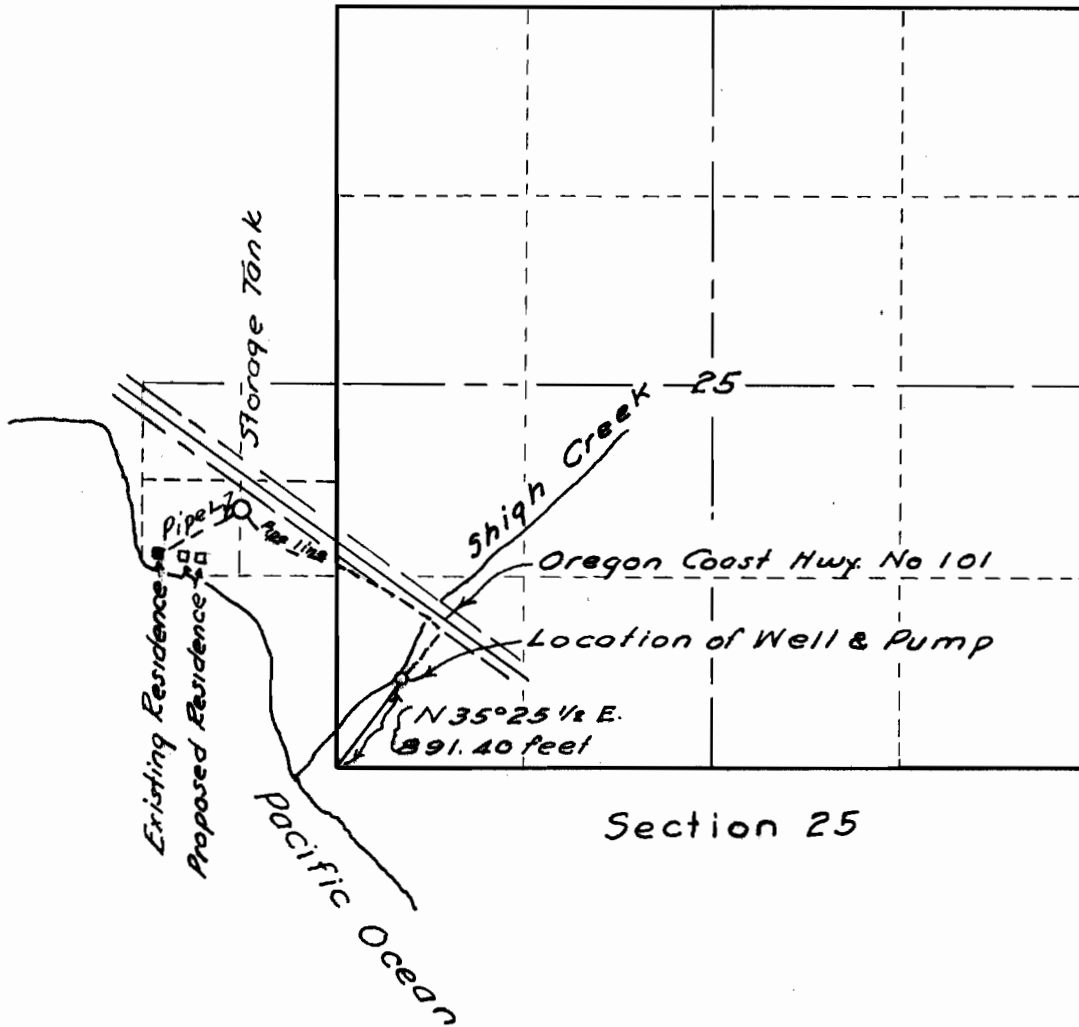

Section 25



I, B.A. Martin of Brookings, Oregon do hereby certify that this map was made from notes taken during an actual Survey made by me on Nov. 16, 1963, and that it correctly represents the works described in the accompanying application together with the location of Stream and well.

Signed: *B.A. Martin*

Scale 1" = 1320 feet.

Nov 29, 1963

Application No. 39424
Permit No. 29293