


T.40S. R.14W. W.M.

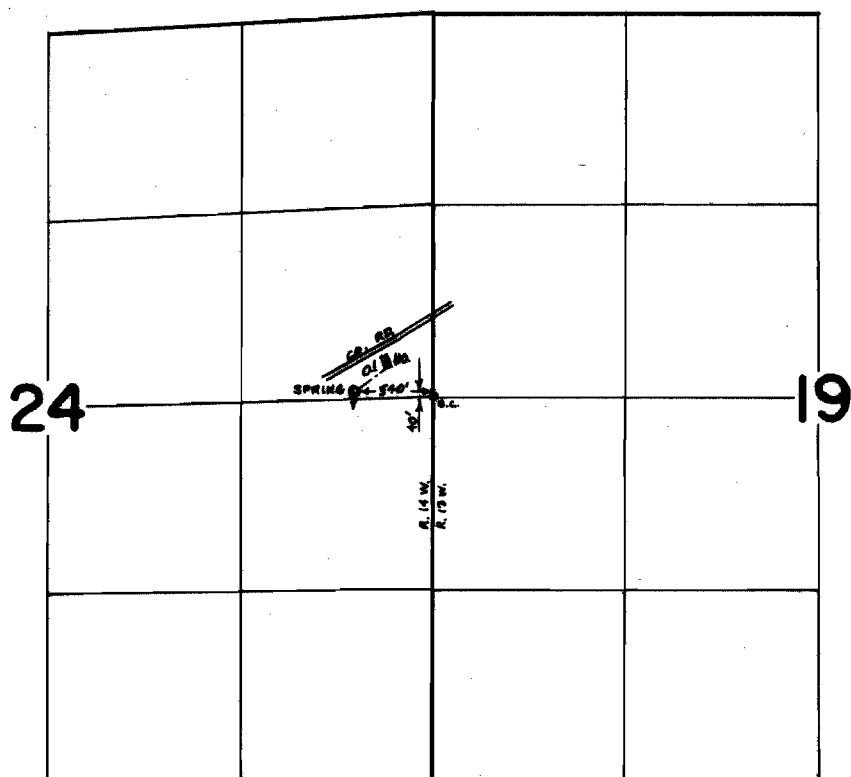

FINAL PROOF SURVEY
UNDER

Application No. 47004 Permit No. 35165
IN NAME OF

HAROLD ARMFIELD

Surveyed JULY 24 1975 by L. TOLL