


T.40S. R.14W. W.M.

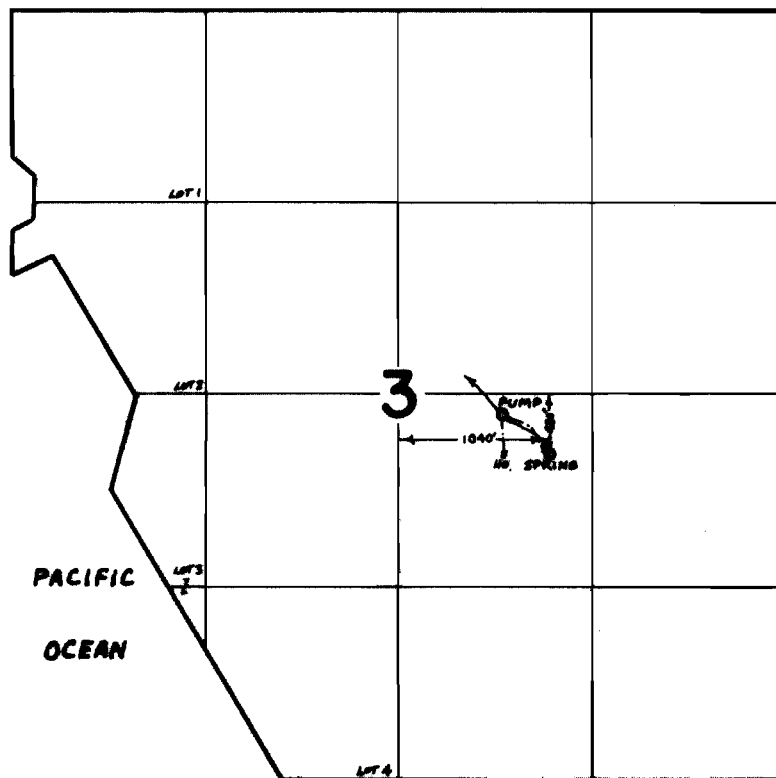

FINAL PROOF SURVEY
UNDER

Application No. 49090 Permit No. 96153.....
IN NAME OF

IRA RALPH & HELEN M. LACY.....

Surveyed JULY 23 1975, by L. TOLL.....