


T.28S.,R.8W.,W.M.

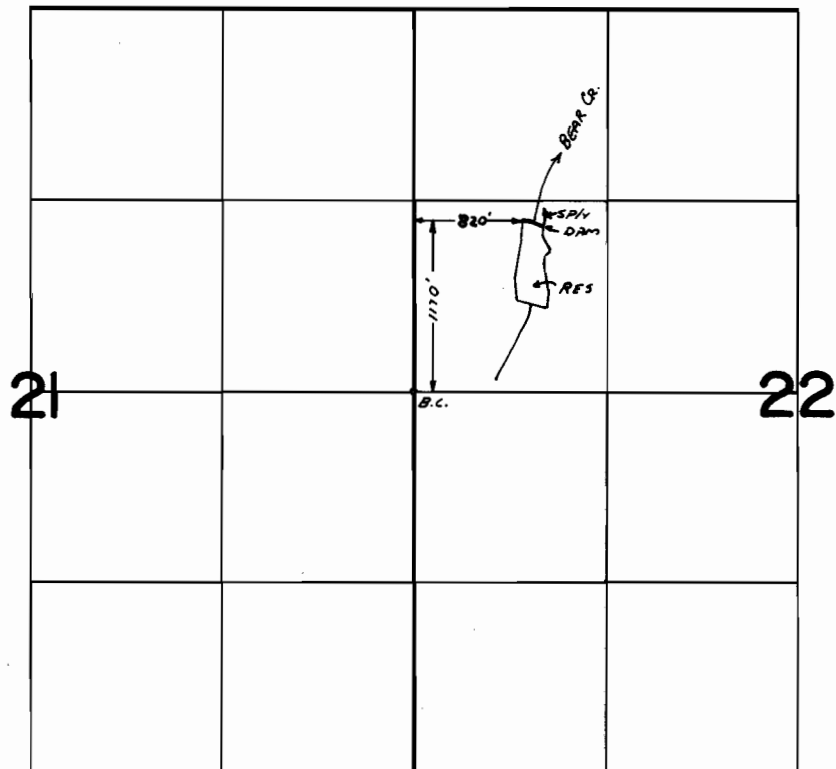

FINAL PROOF SURVEY
UNDER

Application No. **47549** **35795**
R-47759 Permit No. **R-5779**
IN NAME OF

.....Roger D. Iverson.....

Surveyed July 23, 1975, by J. E. Gould.....