


T.28S.,R.8W.,W.M.

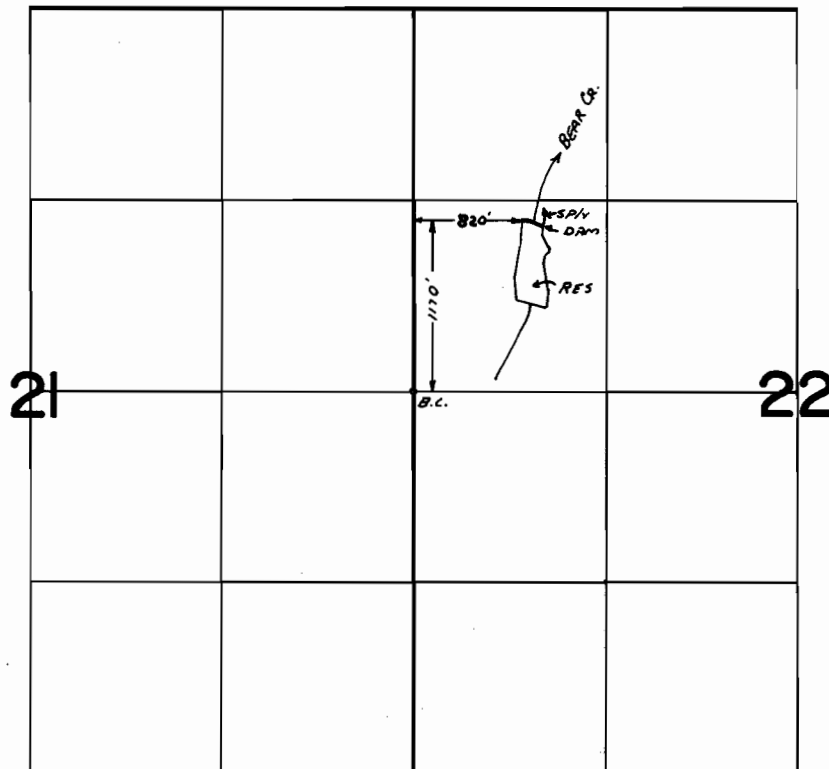


**FINAL PROOF SURVEY**  
UNDER

Application No. **47549** Permit No. **35795**  
**R-47759** **R-5779**  
IN NAME OF

..... Roger D. Iverson .....

Surveyed July 23, 1975, by L.E. Gould.....

**T.28S.,R.8W.,W.M.**

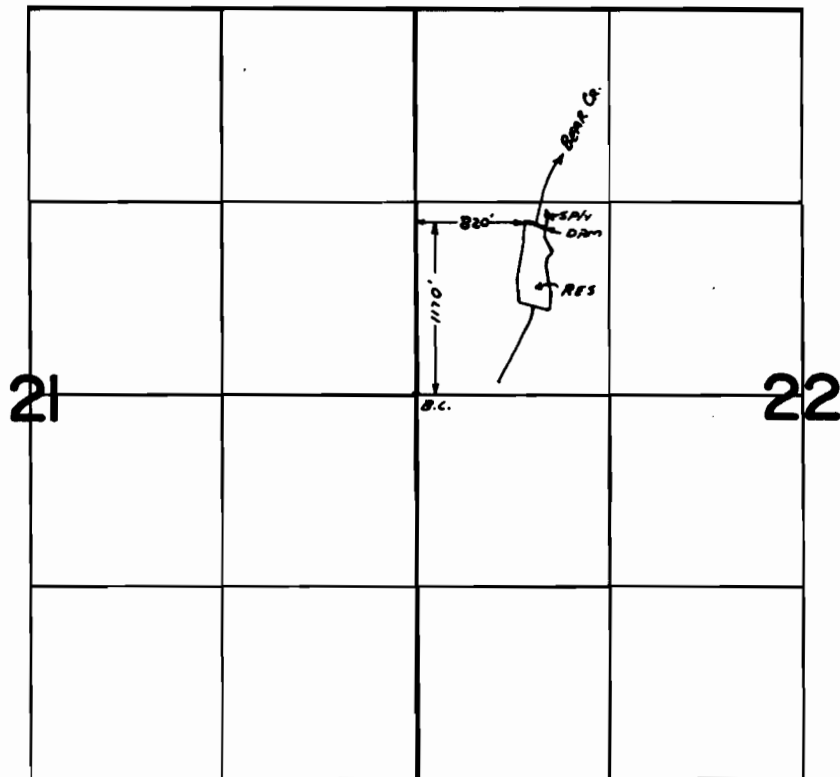

# FINAL PROOF SURVEY

## UNDER

Application No. **47549** Permit No. **35795**  
**R-47759** **R-5779**  
 IN NAME OF  
**LEO SANDERS**

Surveyed July 23, 1975, by L.E. Gould.....