


T.26S., R.4W., W.M.

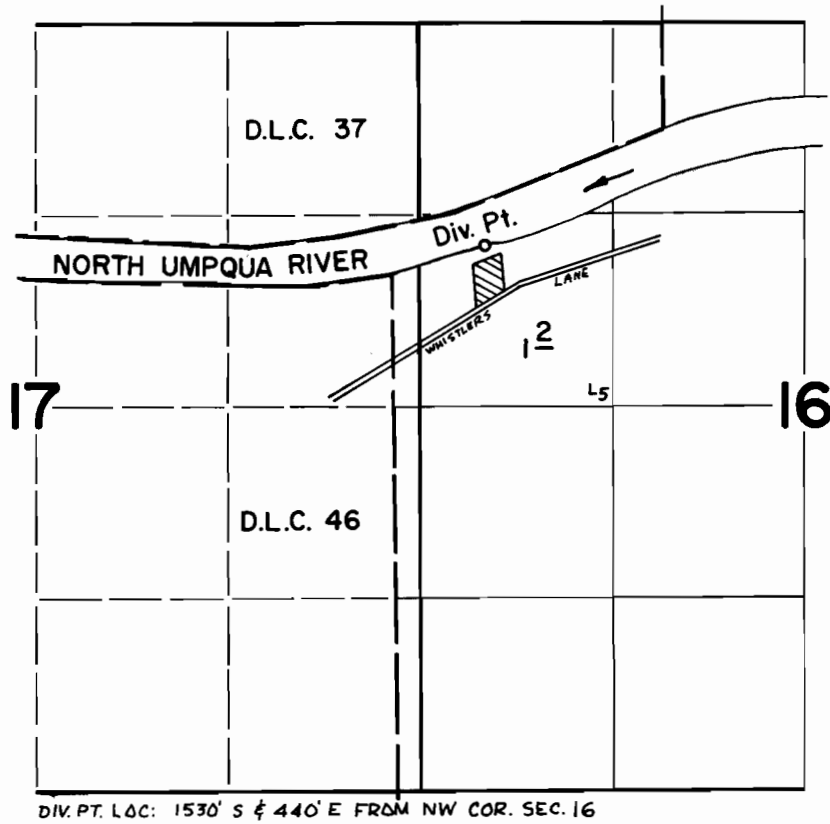

FINAL PROOF SURVEY
UNDER

Application No. 50342 Permit No. 38004
IN NAME OF

D. W. BARKER

Surveyed April 6 1976, by D. Norby