


P. 32212
44591

T.13S., R.28E., W.M.

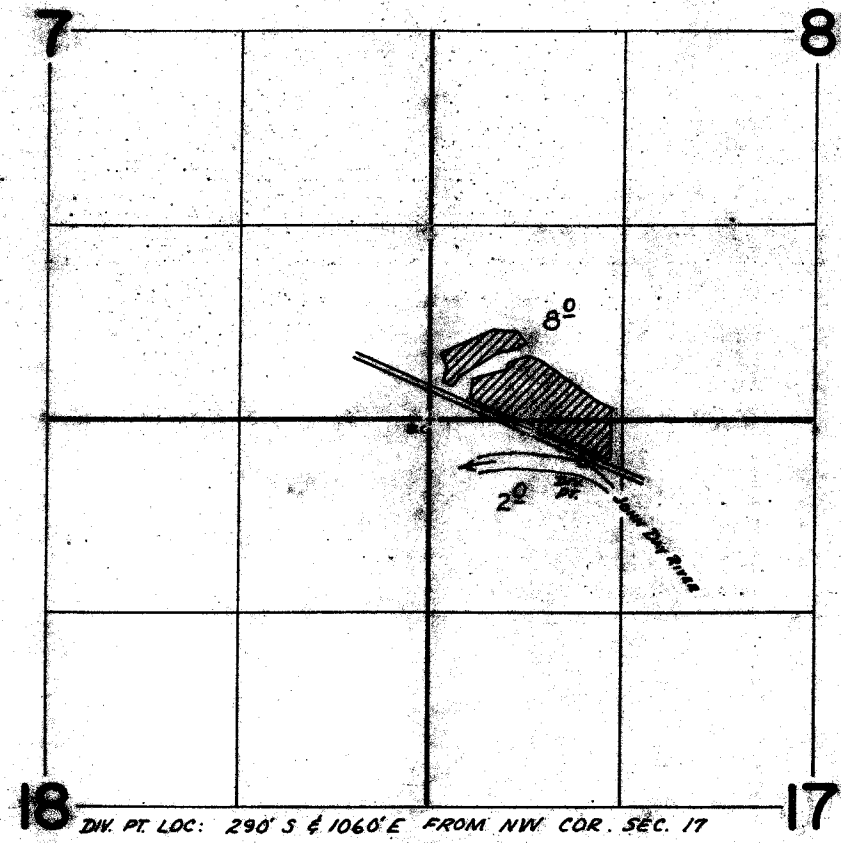

FINAL PROOF SURVEY UNDER

Application No. 43104 Permit No. 32212
IN NAME OF

OLIVER W. TAYLOR

Surveyed June 25 1975, by D. Norby