


T.40&41S.R.33E.W.M.

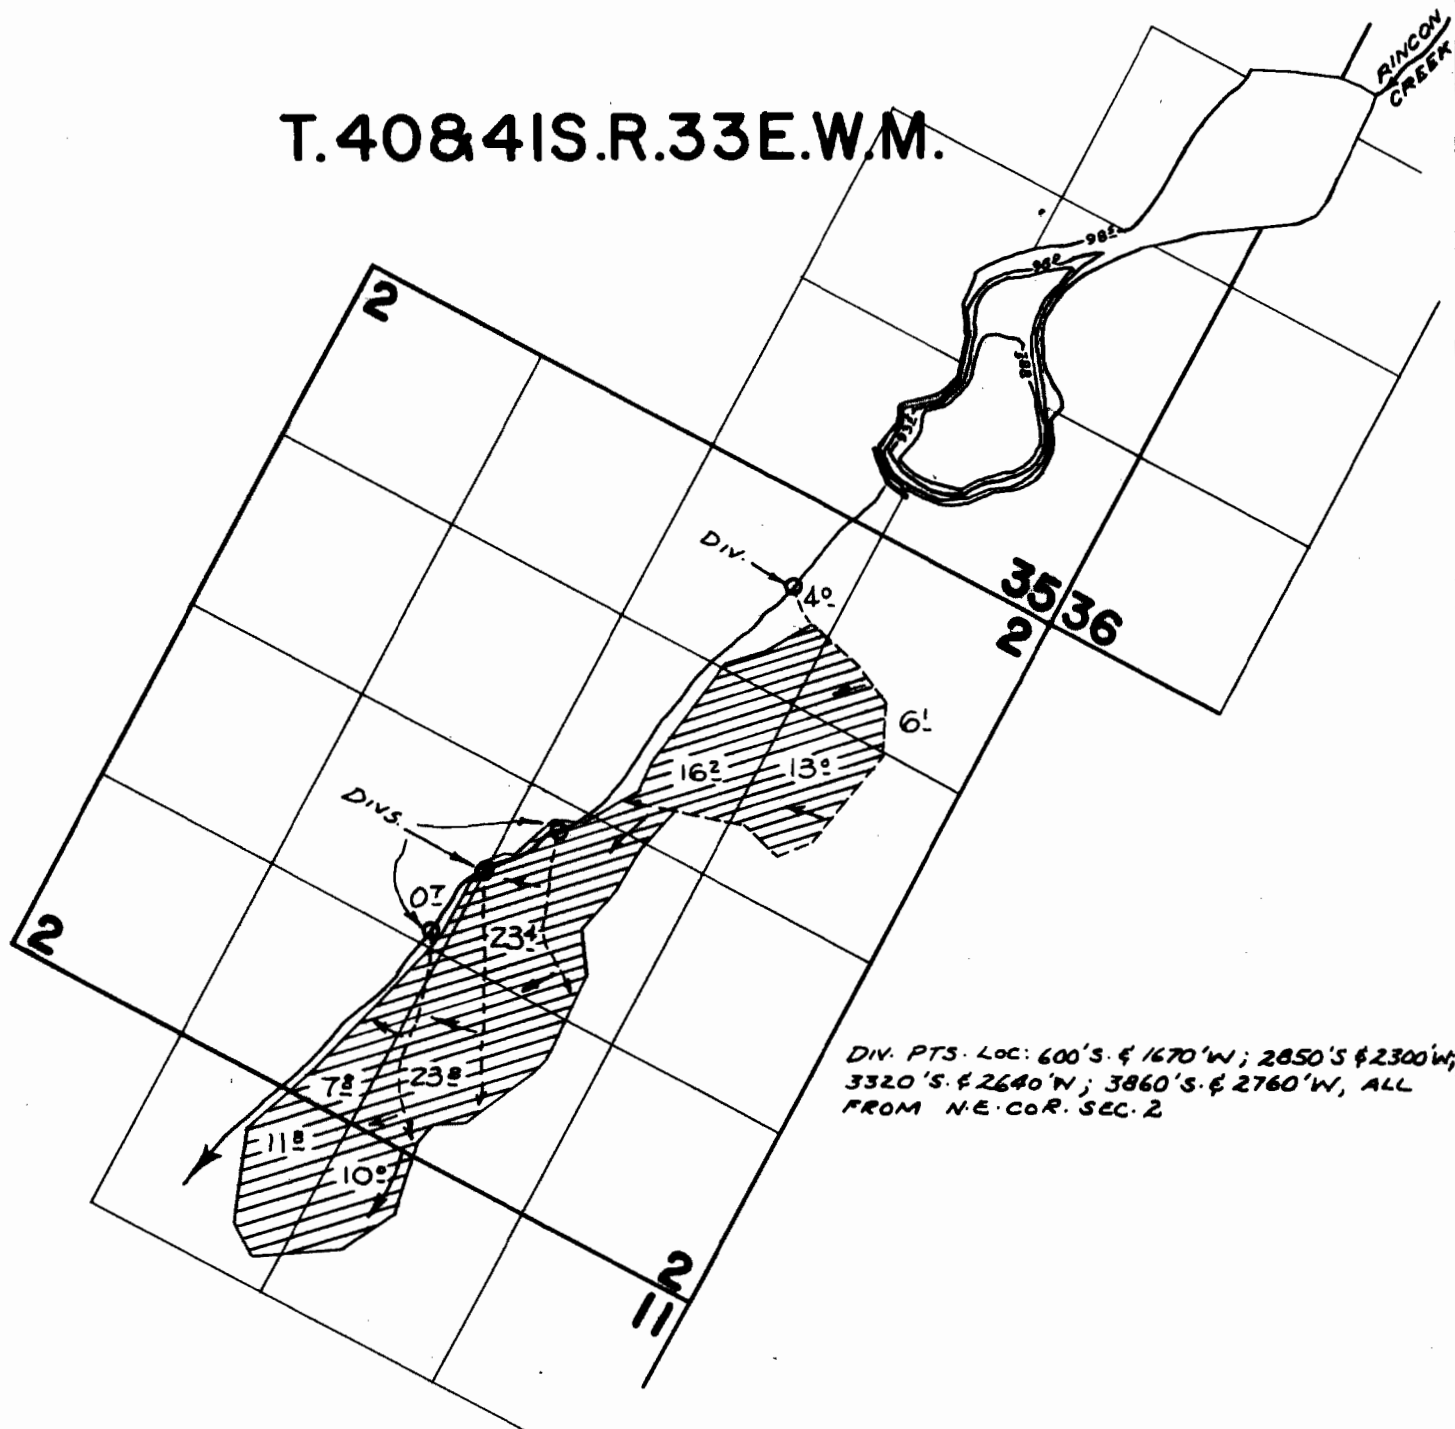

FINAL PROOF SURVEY
UNDER

Application No. 29797... Permit No. 23509...
IN NAME OF

RONALD MCLEAN

Surveyed Aug. 20, 1963, by C.D. BAKER...
Sep. 21, 1965 C. GARDNER
Oct. 18, 1976 R. MUCKEN