


T.23S. R.30E. W.M.

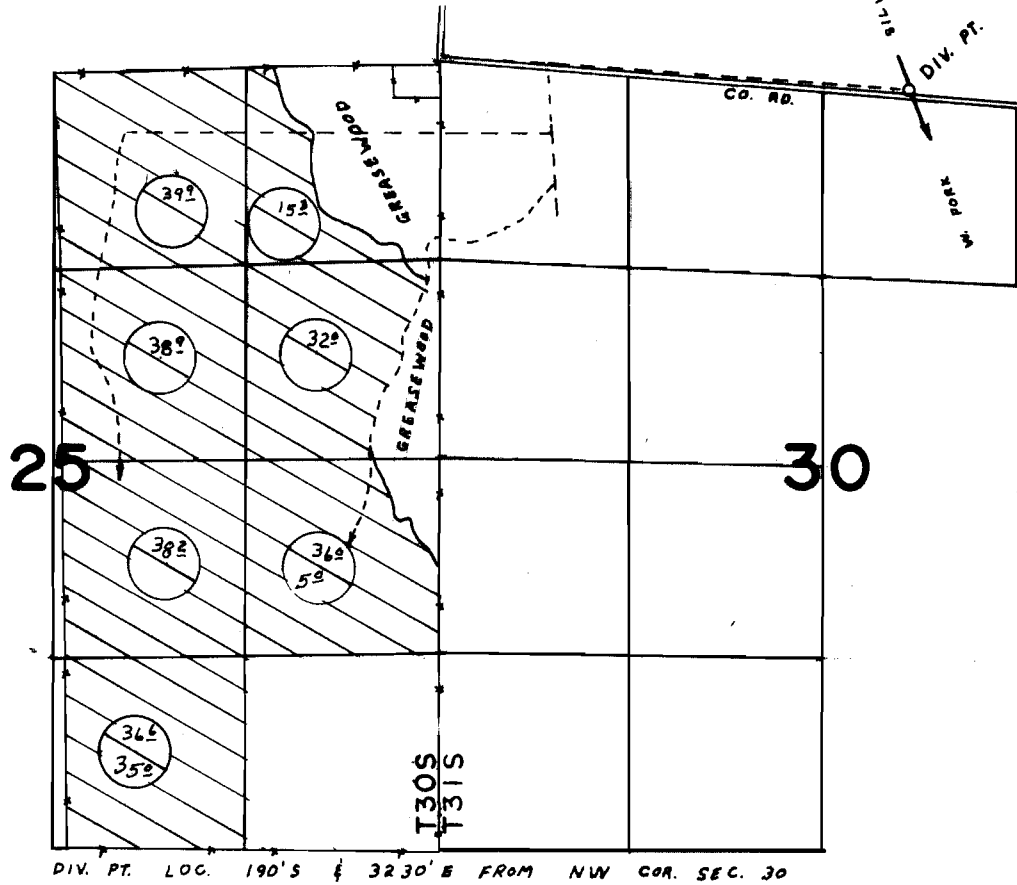

DIV. PT. LOC. 190'S & 3230'E FROM NW COR. SEC. 30

FOUND IRRIGATED
PRIOR RIGHTS

FINAL PROOF SURVEY UNDER

Application No. 40639... Permit No. 30277...
IN NAME OF

HOTCHKISS COMPANY, INC.

Surveyed JUL 31 1975, by LH NUNN