


T.19S. R.29E. W.M.

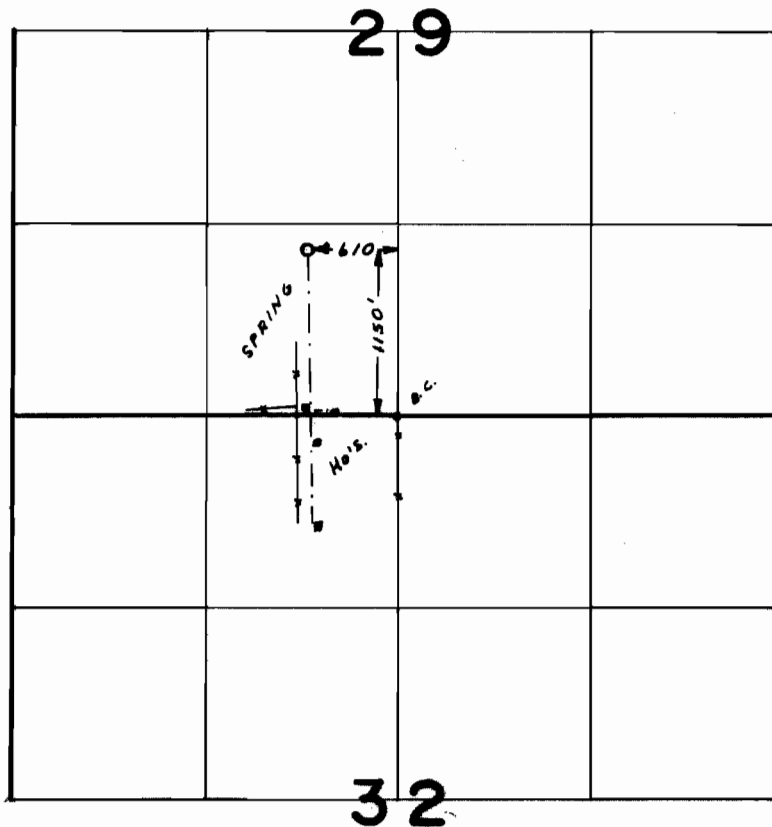

FINAL PROOF SURVEY
UNDER

Application No. 41166 Permit No. 32672
IN NAME OF

TOM CLEMENS

Surveyed JUL. 26 1975, by L.H. NUNN