


T. 37S. R. 2W. W.M.

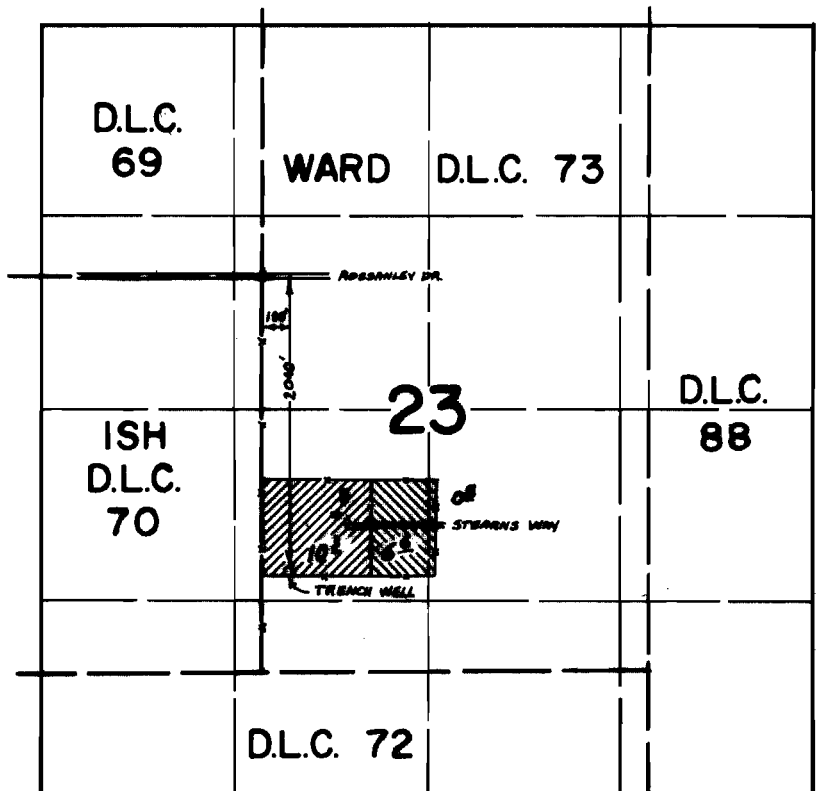

- PRIMARY IRRIGATION
- SUPPLEMENTAL IRRIGATION

FINAL PROOF SURVEY UNDER

Application No. G-5552 Permit No. G-5428
IN NAME OF

JOE E. & FRANCES M. BROOKS

Surveyed OCT. 31 1975, by L. TOLL