


T.40S. R.2W. W.M.

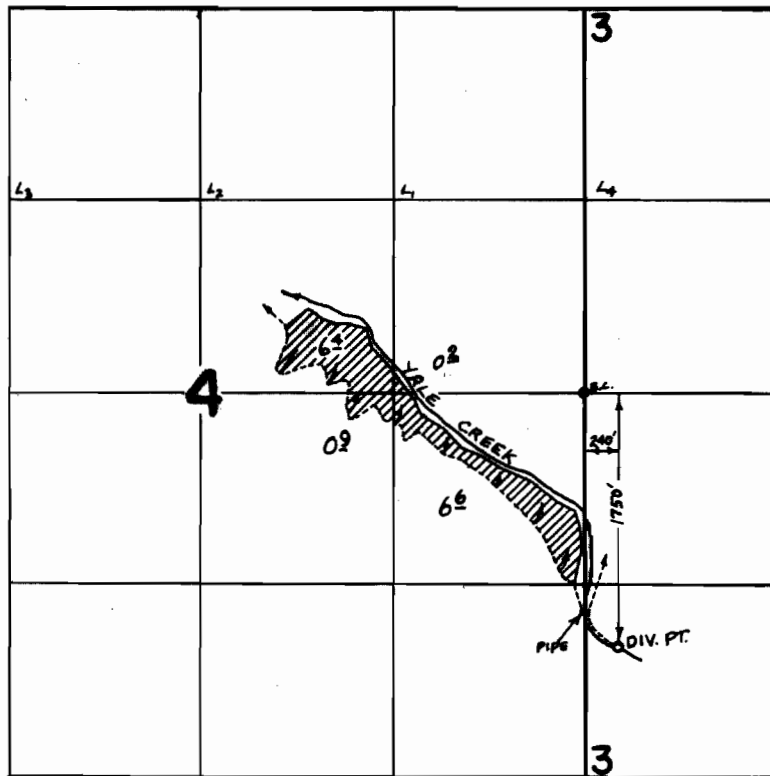

FINAL PROOF SURVEY
UNDER

Application No. 43251... Permit No. 32332...
IN NAME OF

.....ROBERT JAMES SHREEVE.....

Surveyed AUG. 14-15, 1975., by L. TOLL.....