


T.35S., R.2W., W.M.

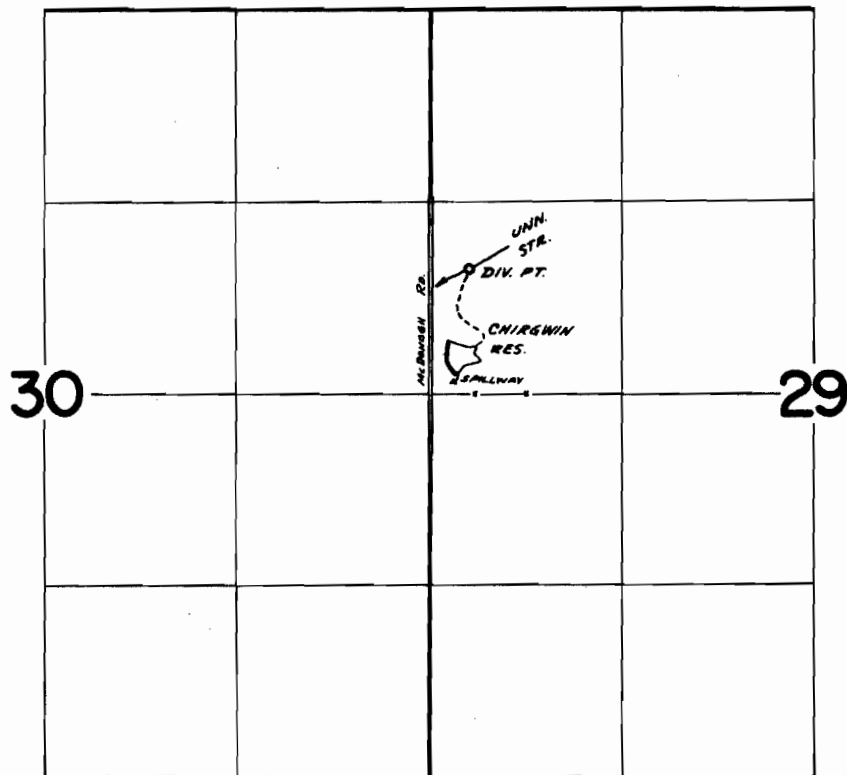

DIV. PTS. LOC: STR. - 860' N & 270' E; RES. - 140' N & 190' E BOTH
FROM W 1/4 COR. SEC. 29

FINAL PROOF SURVEY
UNDER

R-45356 R-5361
Application No. 45357 Permit No. 33865
IN NAME OF

DAVIS F. ADKINS

Surveyed April 30 1975, by D. Norby