


T.34S. R.1W. W.M.

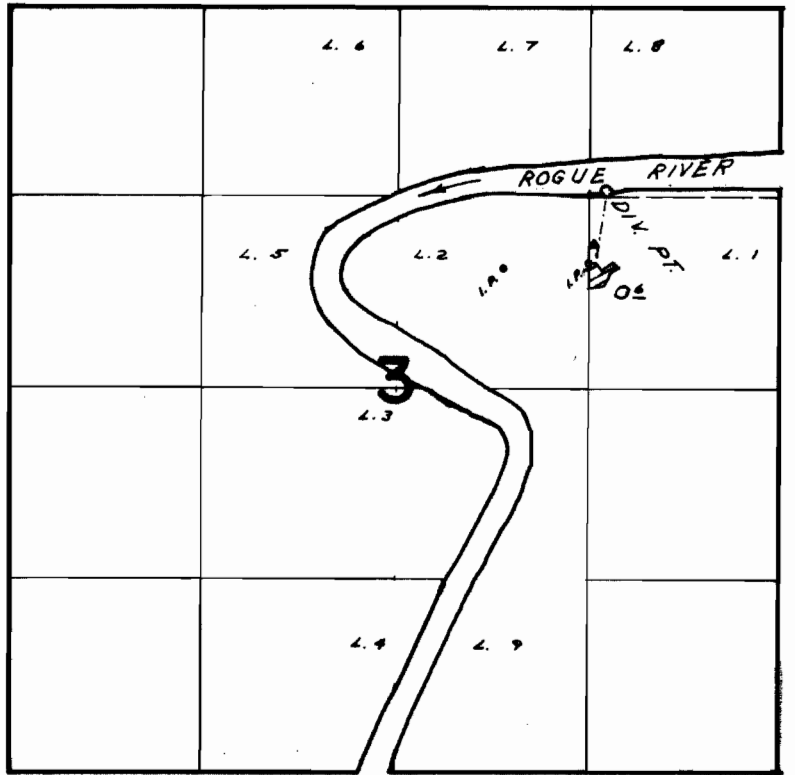

DIV. PT. LOC. 1350' N. & 130' E FROM SW COR. LOT 1

FINAL PROOF SURVEY UNDER

Application No. 46486 Permit No. 34740
IN NAME OF

NATHAN & DORENE KAY

Surveyed APR. 30 1975, by LH NUNN