


T. 39S. R. 3W. W.M.

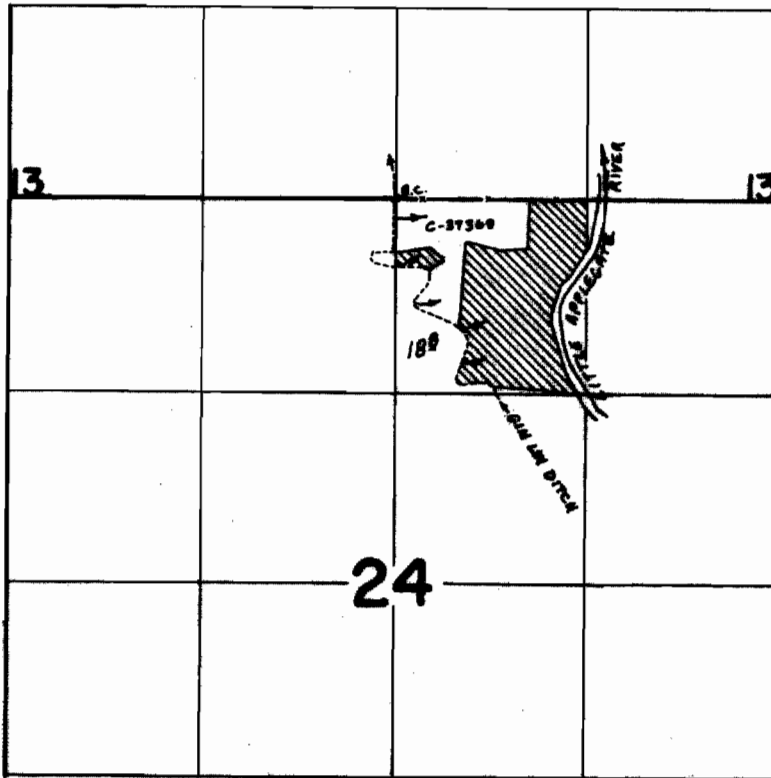

DIV. PT. FROM LITTLE APPLEGATE RIVER LOCATED: 1430'N. + 1905'W.
FROM E 1/4 COR. SEC 29, T. 39S., R. 2W., W.M.

FINAL PROOF SURVEY
UNDER

Application No. 46625 Permit No. 34840
IN NAME OF

HAROLD B. FOWLER

Surveyed AUG. 14 1975, by L. TOLL