


T.35S., R.4W., W.M.

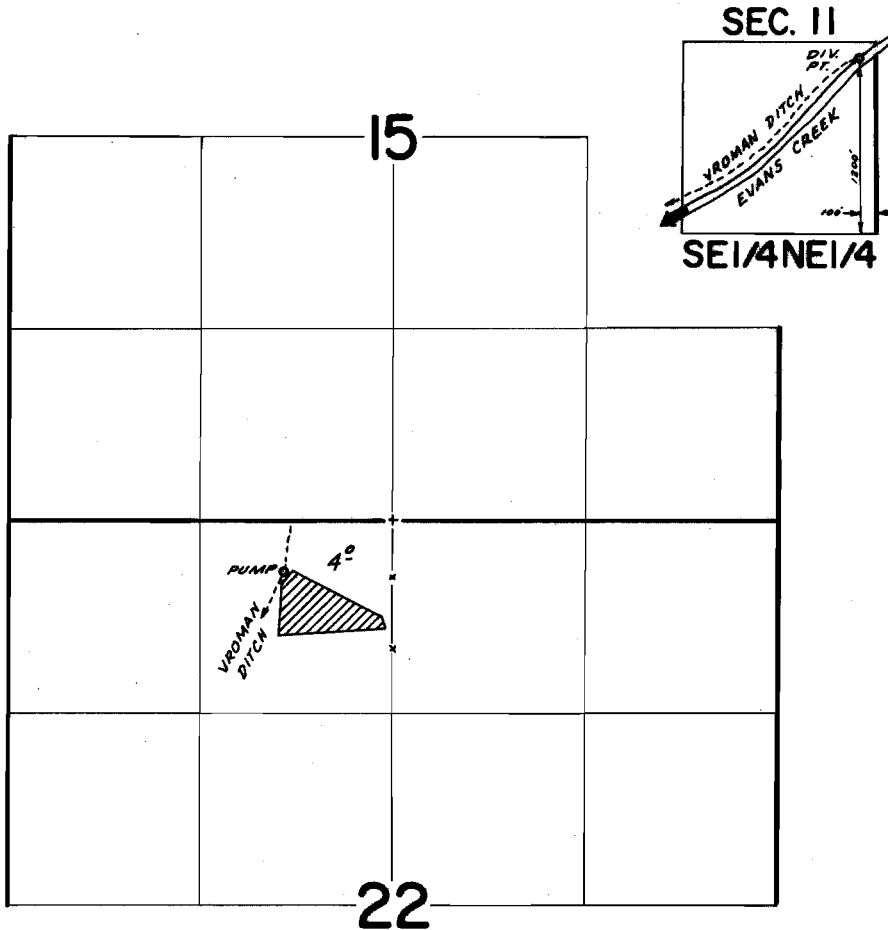

**FINAL PROOF SURVEY**  
UNDER

Application No. 47133 Permit No. 35290  
IN NAME OF

Emberton E. & Dona L. Van Ess

Surveyed Aug. 27 1975, by D. Norby