


T.35S., R.3W., W.M.

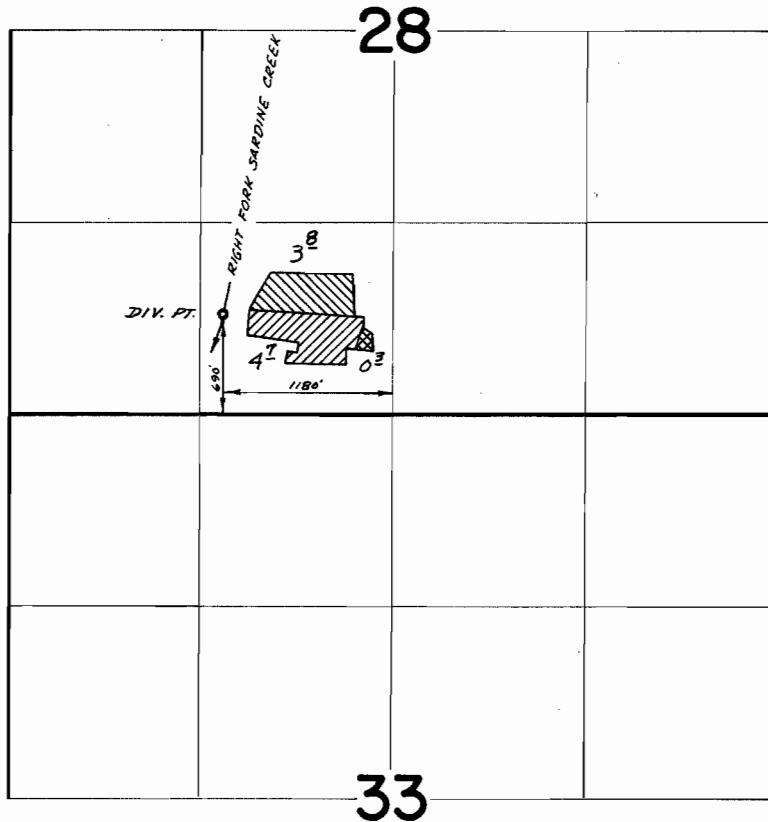

-  PRIMARY APP. 47584
-  SUPPLEMENTAL APP. 47584
-  PRIMARY APP. 49734

FINAL PROOF SURVEY
UNDER

Application No. 47584 49734 Permit No. 35626 37245
IN NAME OF
WILLIAM E. AND MARION R. COLLINS
Surveyed May 2 1975, by D. Norby