


T. 38S. R. 4W. W.M.

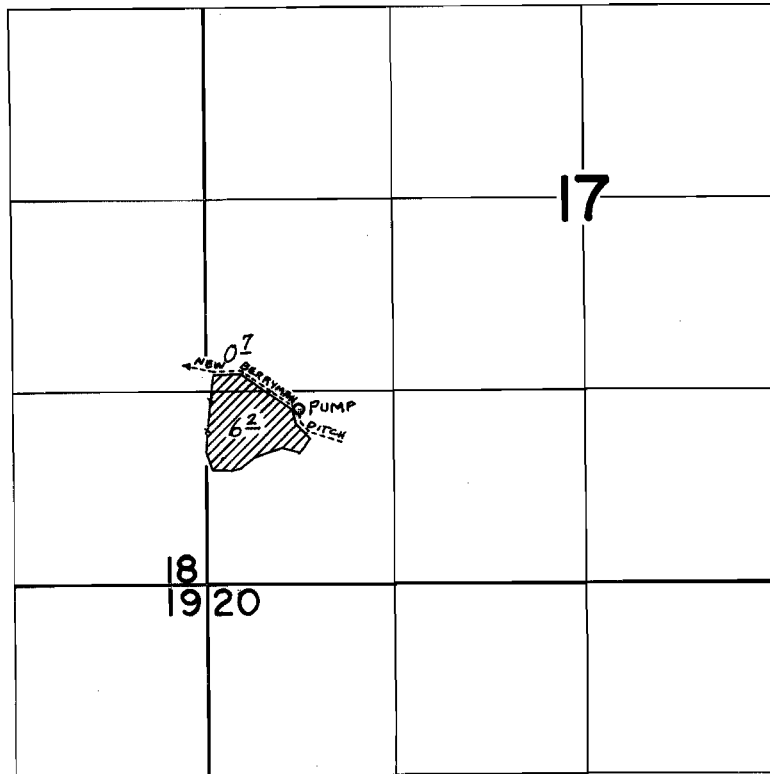

DIV. PT. FROM APPLGATE RIVER LOCATED: 1050'S. & 500'W. FROM N ¼ COR. SEC. 25.

FINAL PROOF SURVEY
UNDER

Application No. 47603 Permit No. 35632
IN NAME OF

DONALD L. GRAINGER

Surveyed AUG. 6. 1975. by L. TOLL