


T.35S., R.2W., W.M.

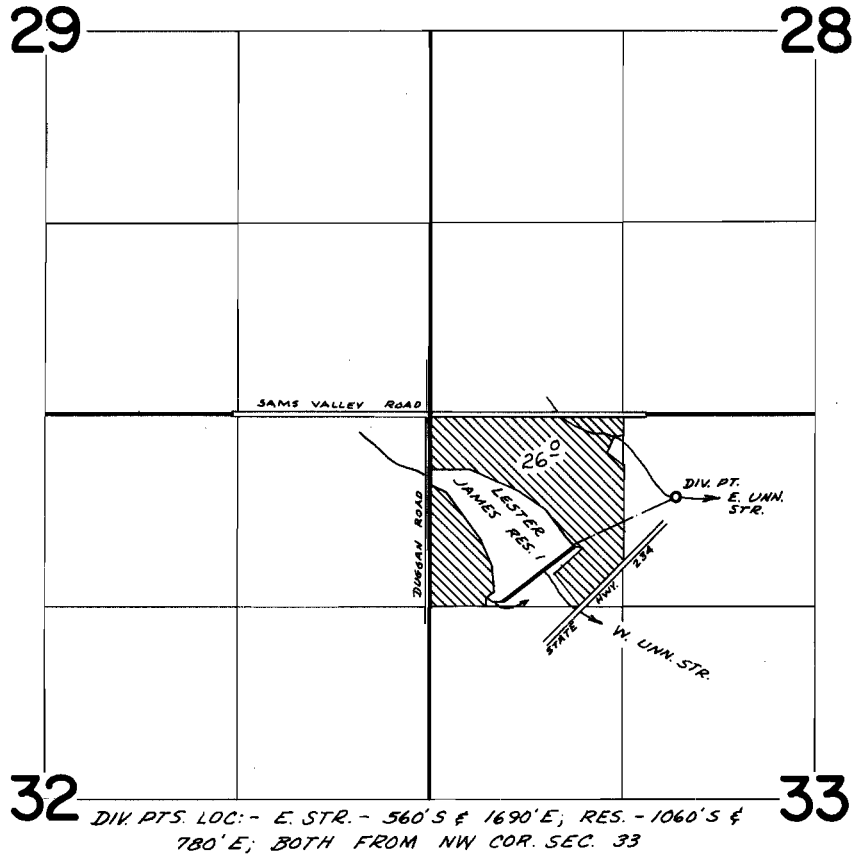

**FINAL PROOF SURVEY**  
UNDER

R-47648 R-5738  
Application No. 47649 Permit No. 35656  
IN NAME OF

LESTER E. JAMES

Surveyed April 30 1975, by D. Norby