


T.35S., R.2W., W.M.

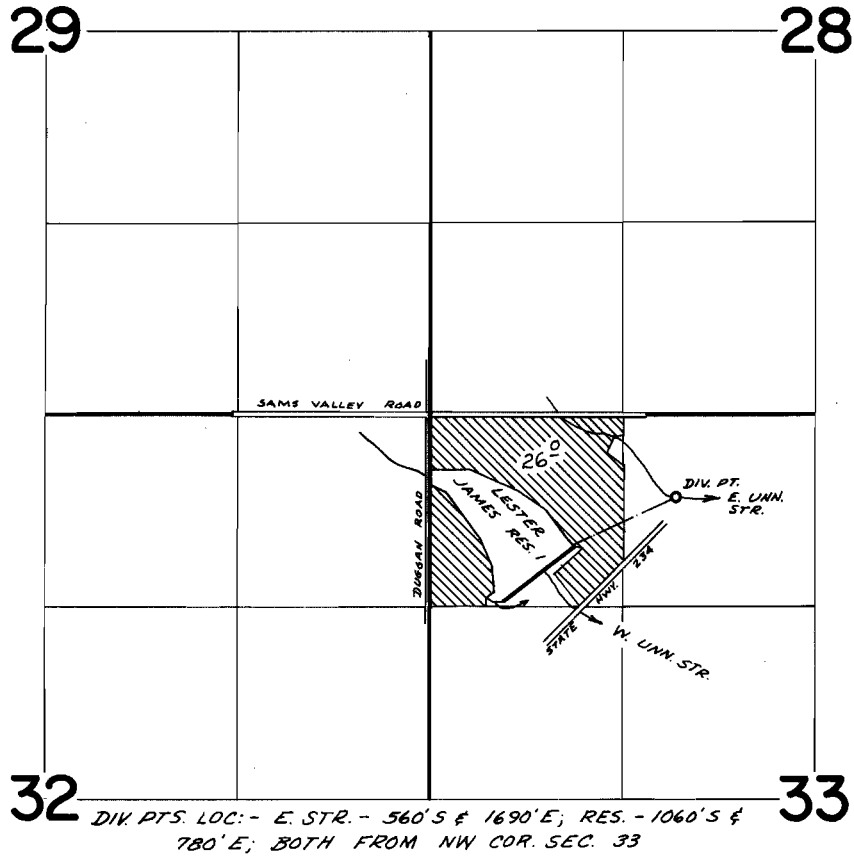

FINAL PROOF SURVEY
UNDER

R-47648 R-5738
Application No. 47649 Permit No. 35656
IN NAME OF

LESTER E. JAMES

Surveyed April 30 1975, by D. Norby