


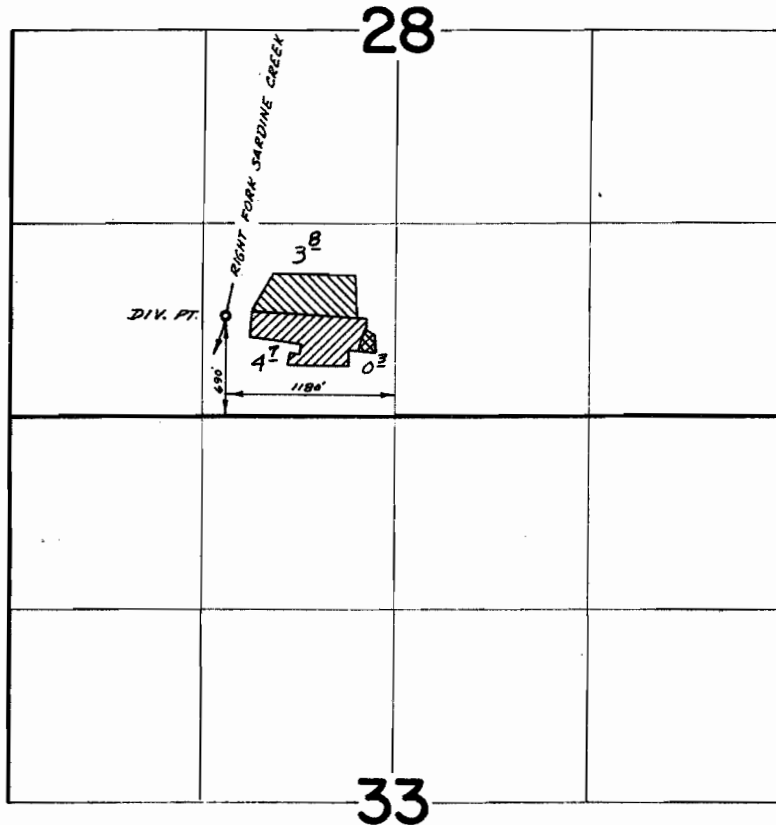


T.35S., R.3W., W.M.



-  PRIMARY APP. 47584
-  SUPPLEMENTAL APP. 47584
-  PRIMARY APP. 49734

FINAL PROOF SURVEY
UNDER

Application No. 47584 Permit No. 35626
49734 37245
IN NAME OF

WILLIAM E. AND MARION R. COLLINS

Surveyed May 2 1975, by D. Norby