


T.33S., R.1W., W.M.

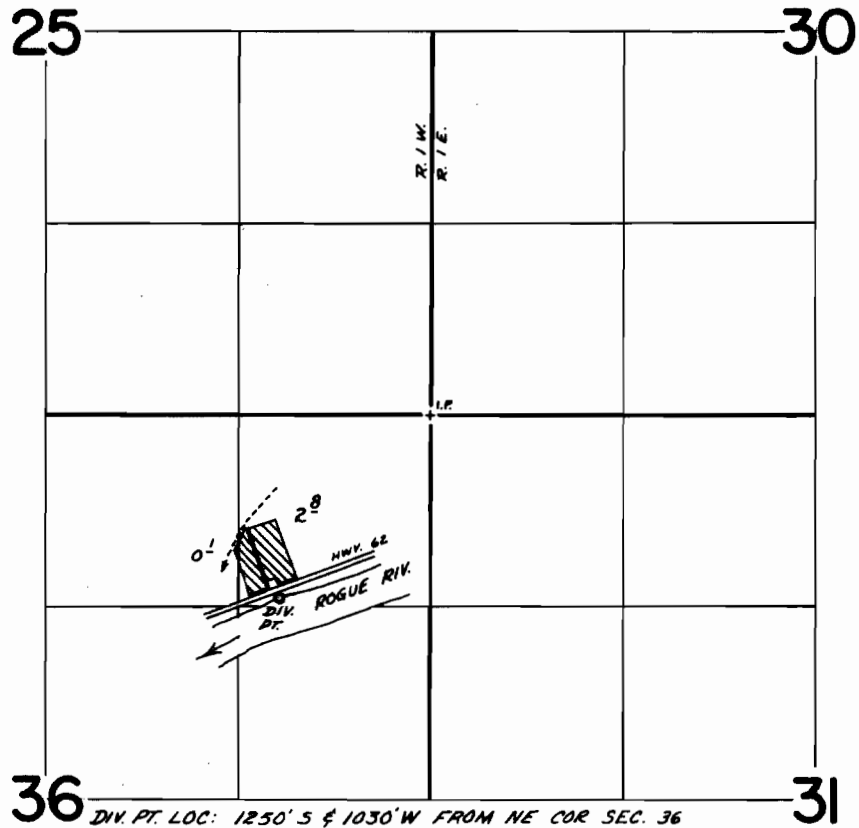

**FINAL PROOF SURVEY**  
UNDER

Application No. 50046 Permit No. 37620  
IN NAME OF

EDWARD J. GUIDRY AND ROY K. VAUGHN

Surveyed Aug. 22 1975, by D. Norby