


T.34S., R.1W., W.M.

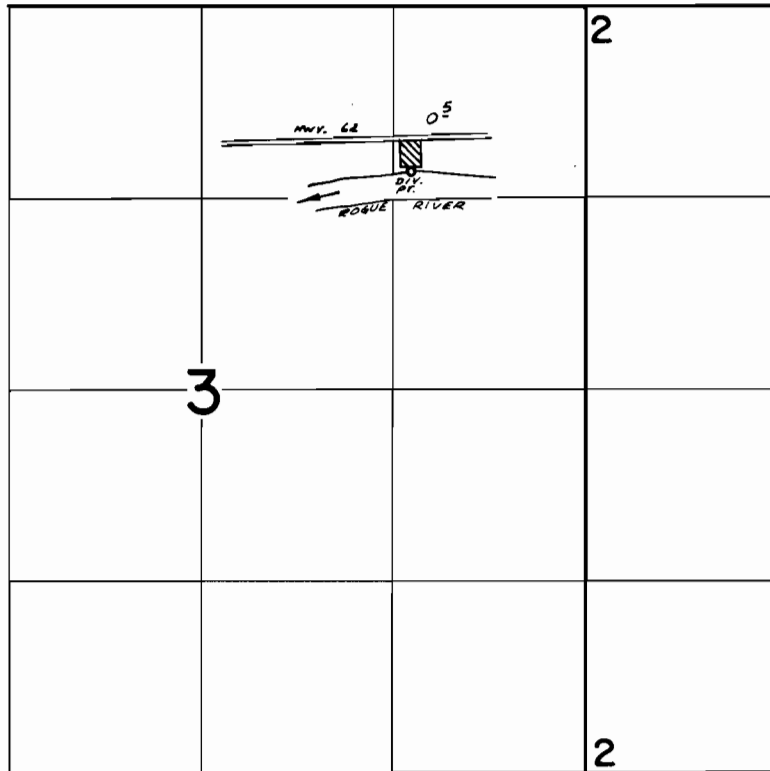

DIV. PT. LOC: 1130'S & 1440'E FROM N 1/4 COR. SEC. 3.

FINAL PROOF SURVEY
UNDER

Application No. 50209..... Permit No. 37699.....
IN NAME OF

WALLACE C. OR RITA M. WILSON

Surveyed Aug. 21, 1975, by D. Norby.....