


T.13&14S.,R.14E.,W.M.

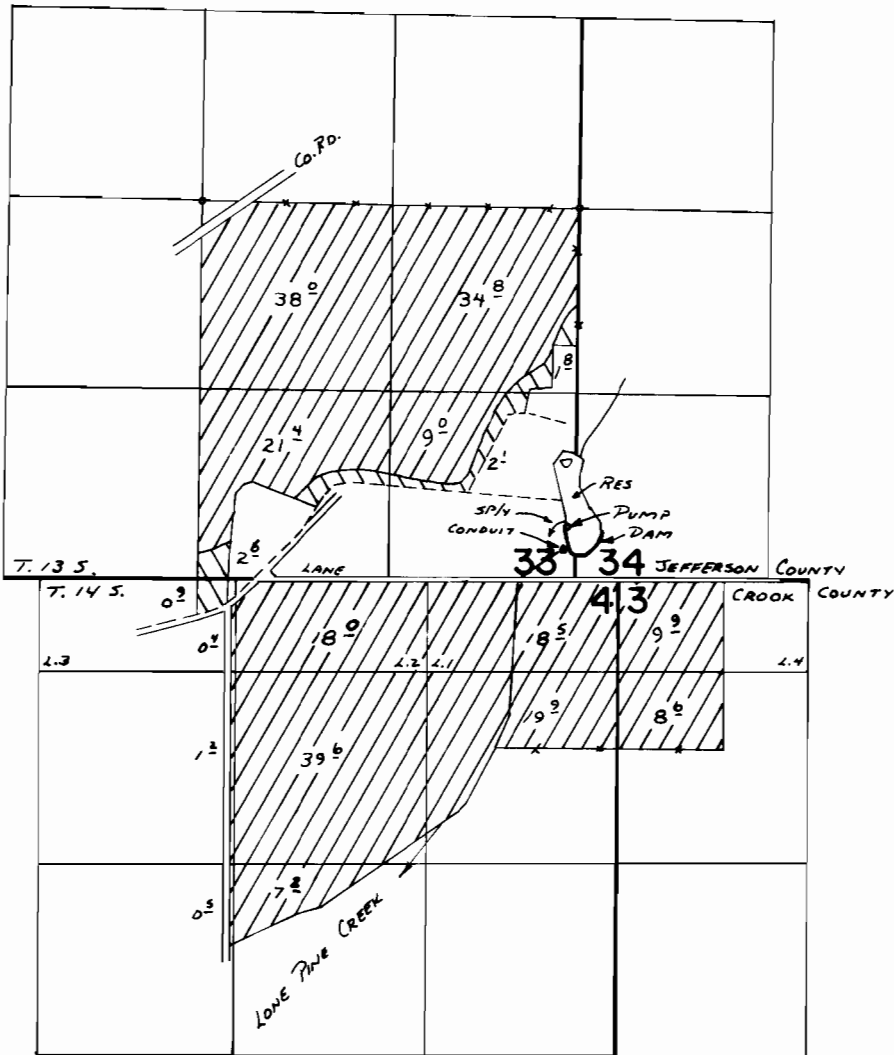

DAM Loc: 200' N AND 50' W FROM SE COR SEC 33

 - PRIMARY  - SUPPLEMENTAL

FINAL PROOF SURVEY UNDER

Application No. 38345 Permit No. 28702
~~R-38344~~ ~~R-3248~~
 IN NAME OF

BUCKNER BROTHERS

Surveyed JUNE 17 19 75 by L. E. GOULD