


T.40S. R.8W. W.M.

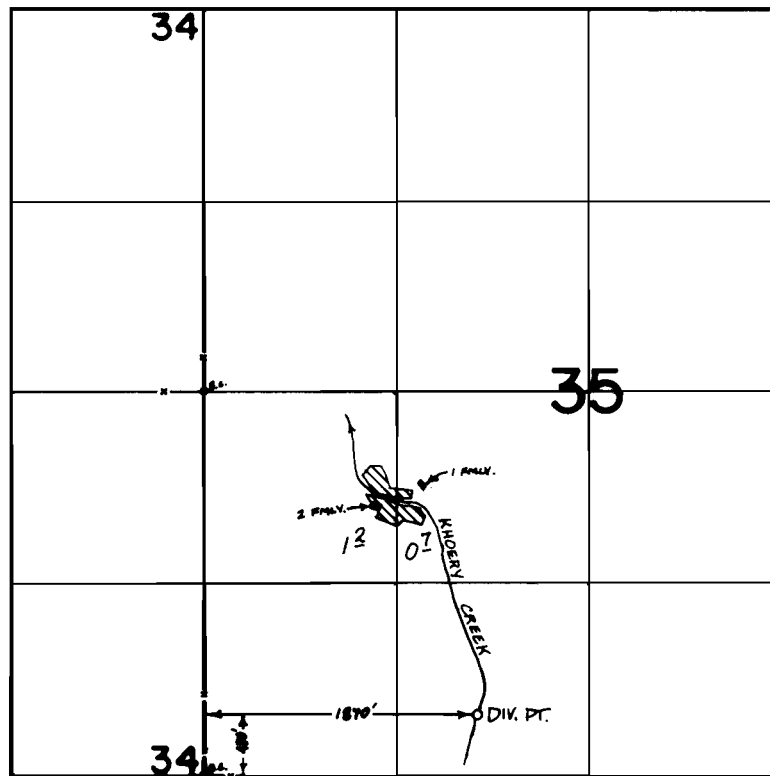

FINAL PROOF SURVEY
UNDER

Application No. 46149 Permit No. 34478
IN NAME OF

JOSEPH WILLIAM PATTON

Surveyed MAY 7 1975, by L. TOLK