


T.38 S. R.5 W. W.M.

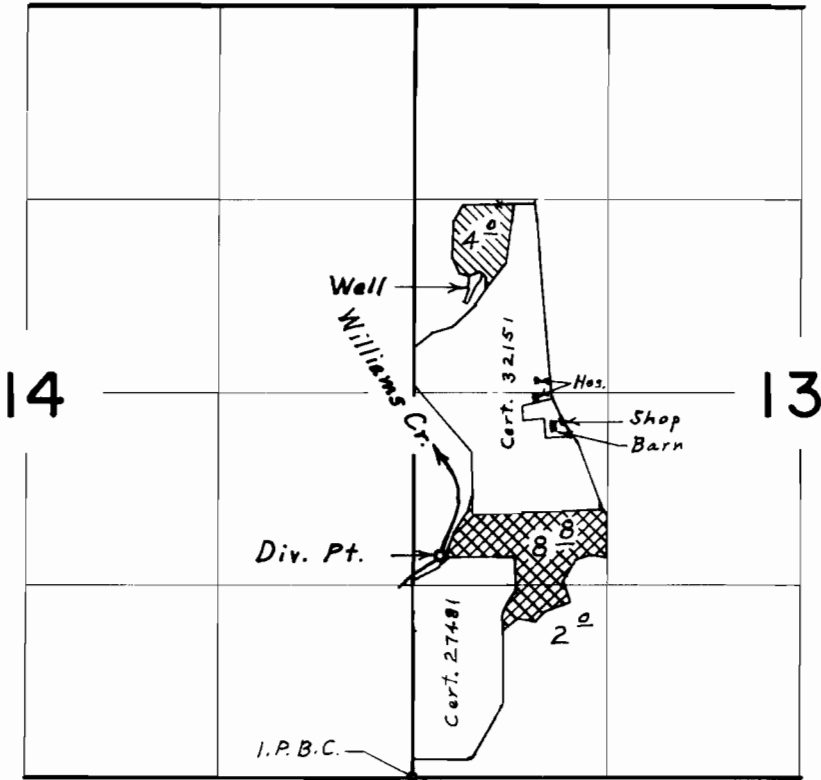

Div. Pts. located: Well, 3370' N. & 400' E.; Str., 1520' N. & 180' E., both from S.W. Corner Section 13

FINAL PROOF SURVEY
UNDER

Application No. ⁴⁶¹⁷⁵ G-4920 Permit No. ³⁴⁵⁰⁶ G-4637
IN NAME OF

Prim.  Supp. 

ROBERT W. & LYNNE CHRISTENSEN

Surveyed May 21, 1975, by L. E. Gould