


34928

44624

# T.34S. R.9E. W.M.

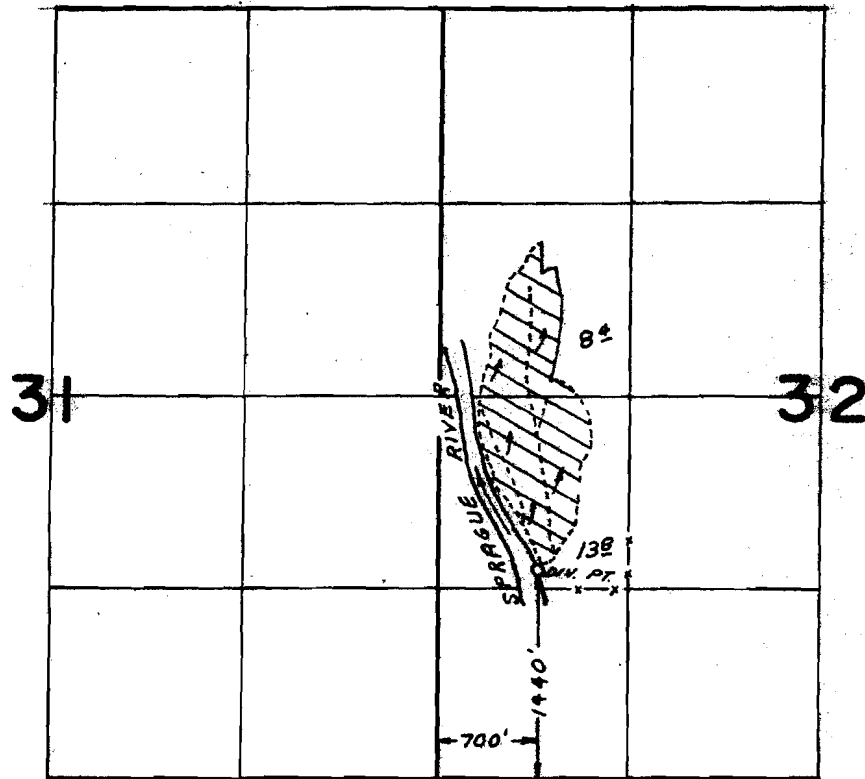

*Sprague River*

## FINAL PROOF SURVEY UNDER

Application No. 46772 Permit No. 34928  
IN NAME OF

W. K. PLUMMER

Surveyed JUN. 12. 1975, by L.H. NUNN.....