


T.17S. R.5W. W.M.

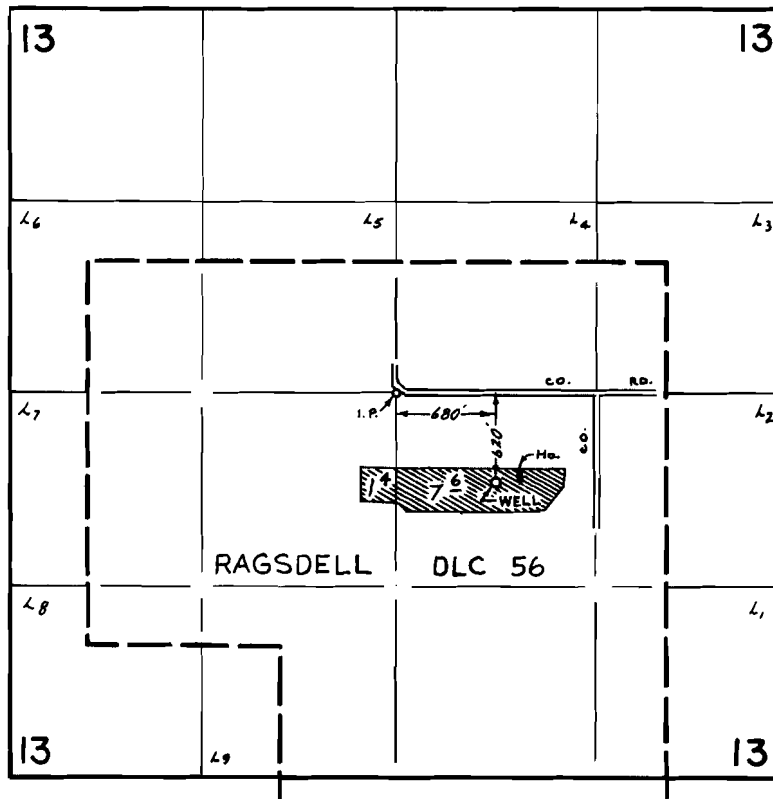

**FINAL PROOF SURVEY**  
UNDER

Application No. G-5303 Permit No. G-5133  
IN NAME OF

HENRY O. ODEGARD

Surveyed May 1, 1975, by R. Mucken