


T.17S. R.2W. W.M.

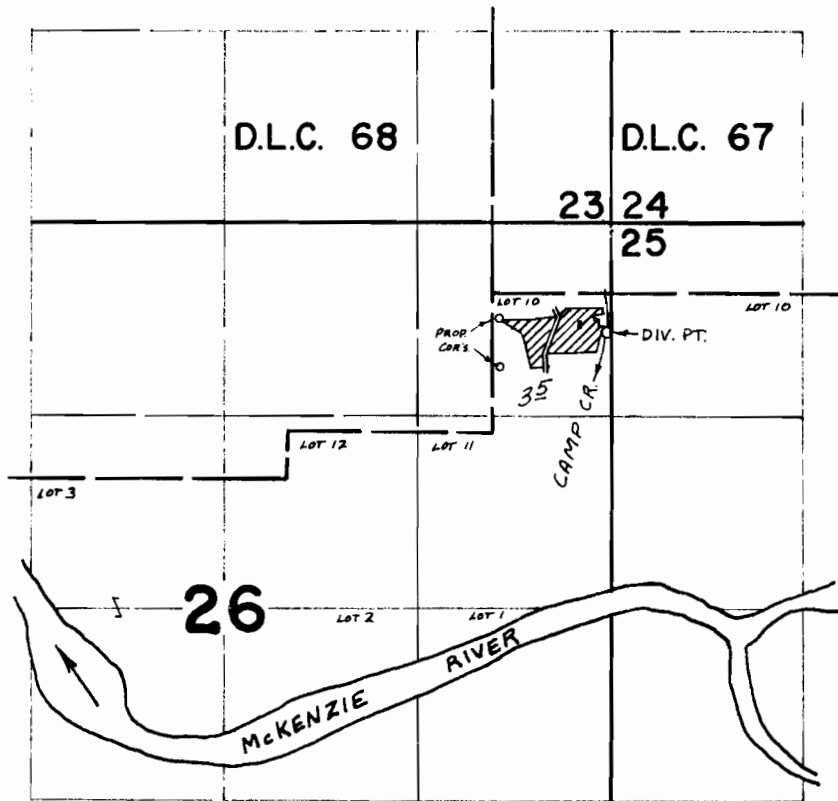

DIV. PT. LOCATED: 760'S + 30'W. FROM NE COR SEC. 26

PLAT

42720

31918

REANOUS JESS COCHRAN

JULY 8 75

L. TOLL