


T.19S. R.1W. W. M.

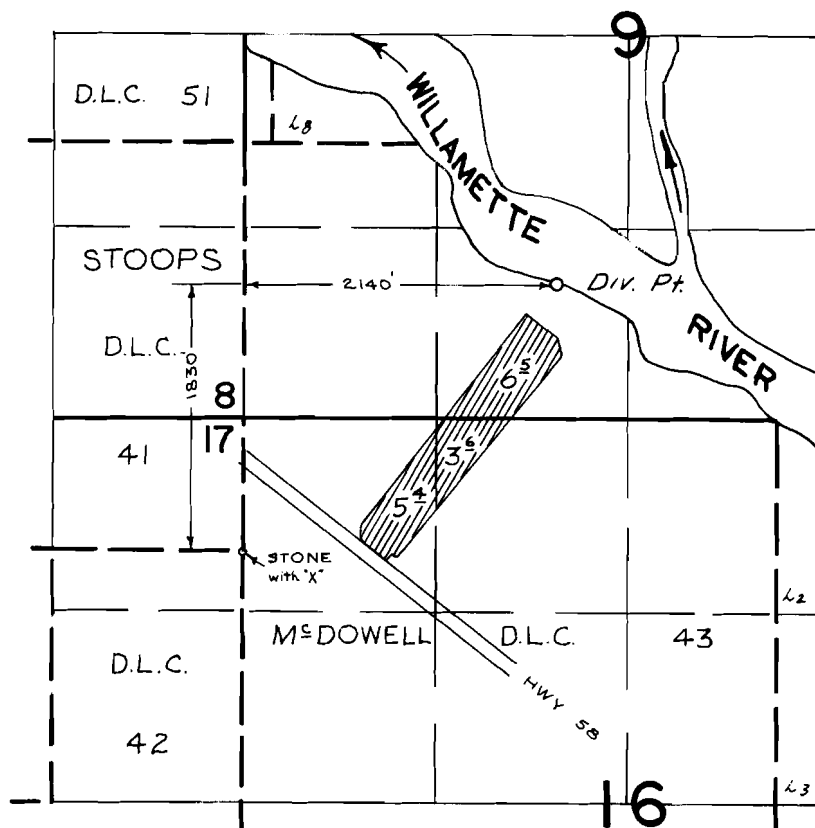

FINAL PROOF SURVEY UNDER

Application No. 45848 Permit No. 34229
IN NAME OF

HENRY & PHYLLIS HOFFMAN

Surveyed April 18, 1975, by R. Mucken