


31304

T.1S. R.12&13E. W.M.

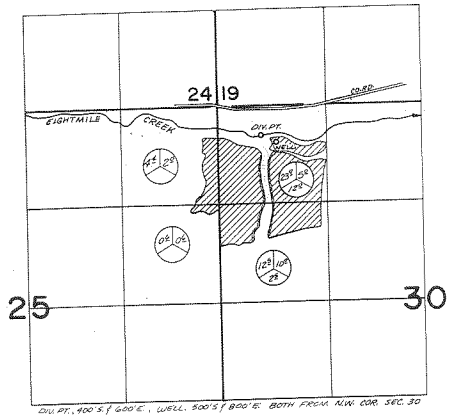


 SUPPLEMENTAL PERMIT 4236 SUPPLEMENTAL PERMIT 31304
 PRIMARY PERMIT 31304

FINAL PROOF SURVEY UNDER

Application No. G 494 G 4236
 41823 Permit No. 31304
 IN NAME OF
August T. & Myrtle Gehrig
 Surveyed JULY 18, 1975, by T. PAUL