


T.19S.,R.1W.,W.M.

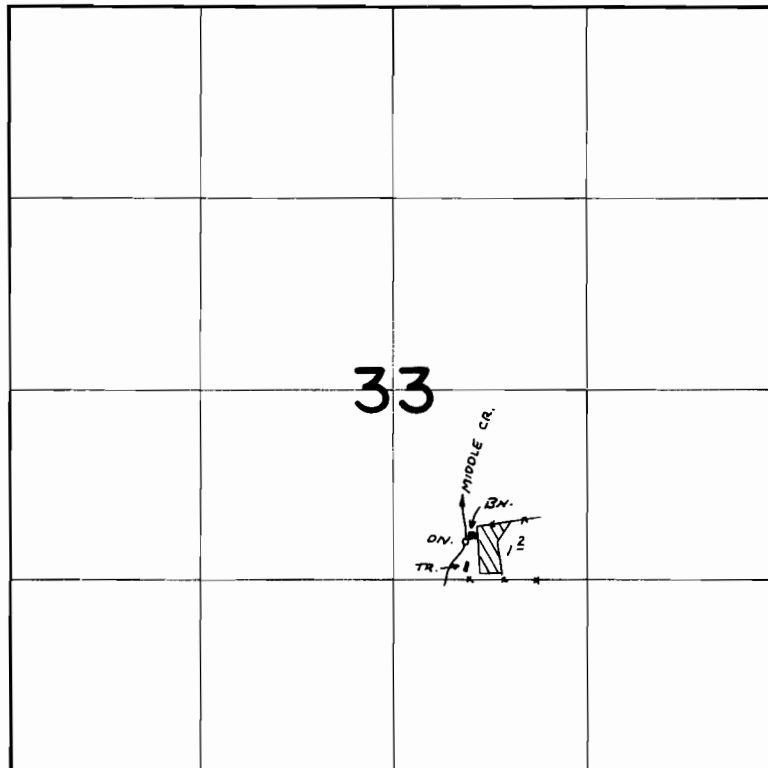

DIV. LOC: 1580' N AND 500' E FROM 3/4 COR, SEC 33

FINAL PROOF SURVEY
UNDER

Application No. 46923 Permit No. 34918
IN NAME OF

Mrs. Josephine Hayes

Surveyed SEPT. 18 1975, by L. Tell