


T.19S. R.1W. W. M.

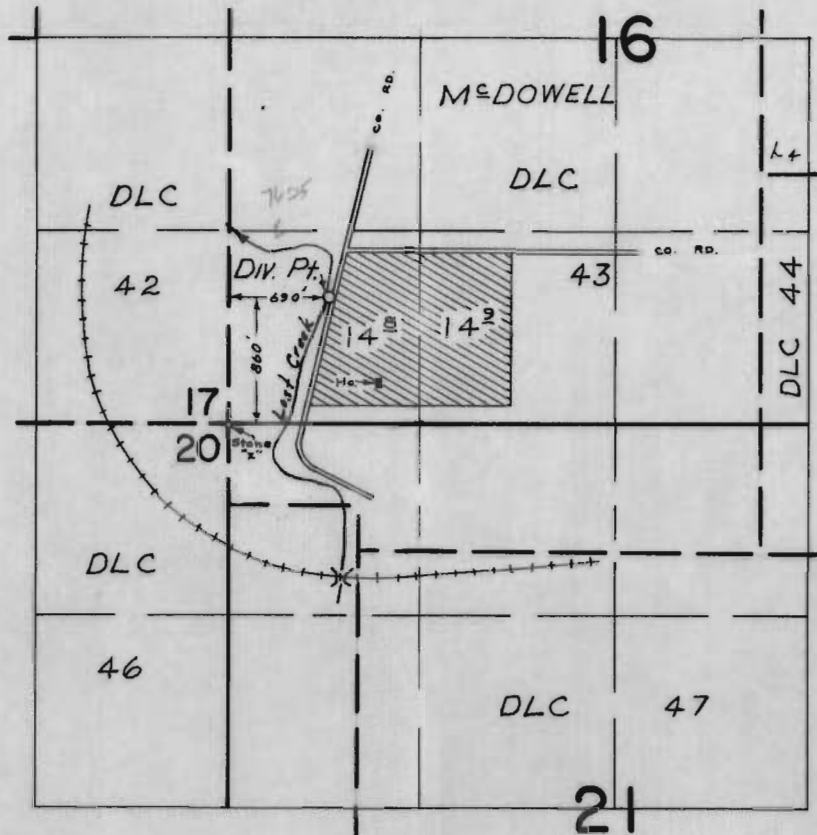

FINAL PROOF SURVEY
UNDER

Application No. 48072 Permit No. 35226
IN NAME OF

PAUL E. & VIVIAN DAY

Surveyed April 17, 1975, by R. Mucken