


T.17S. R.6W. W.M.

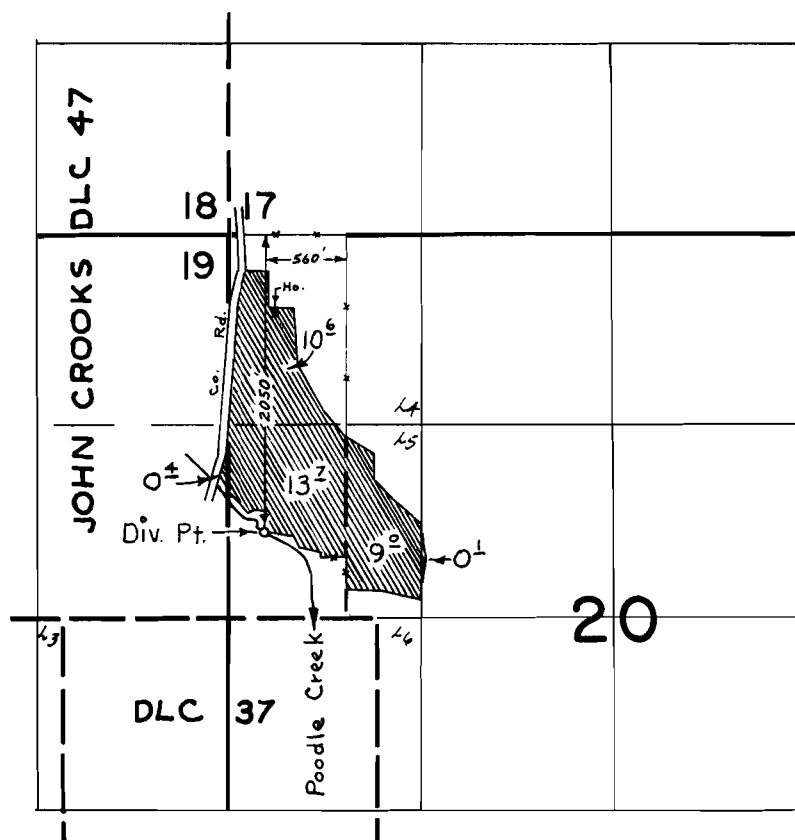

FINAL PROOF SURVEY
UNDER

Application No. 47339 Permit No. 35463
IN NAME OF

DALTA LEE COOK

Surveyed April 30, 1975, by R. Mucken