


T.10S. R.39E.W.M.

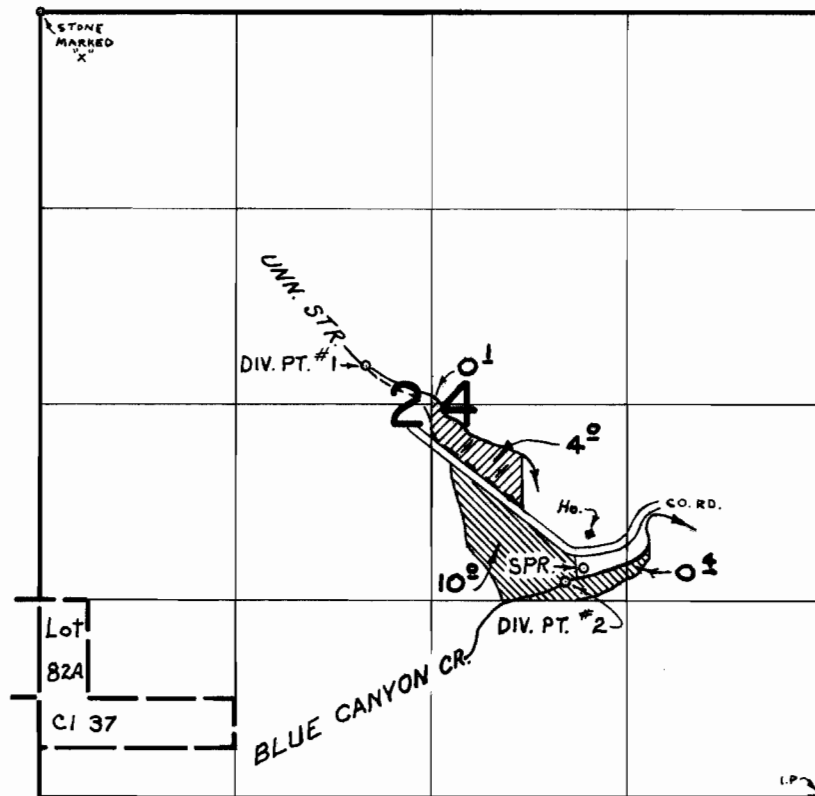

DIV. PTS. LOC: NO. 1 - 2970' N. & 3150' W., NO. 2 - 1480' N. & 1780' W., SPRING - 1570' N. & 1650' W. ALL FROM SE. CORNER SECTION 24.
/// — IRR. FROM UNN. STR. /// — IRR. FROM B. CANYON CR.

FINAL PROOF SURVEY
UNDER

Application No. 37993 Permit No. 28431
IN NAME OF

MELVIN L. COPLEY

Surveyed AUG. 22, 1975, by R. MUCKEN