



T.11S., R.3W., W.M.

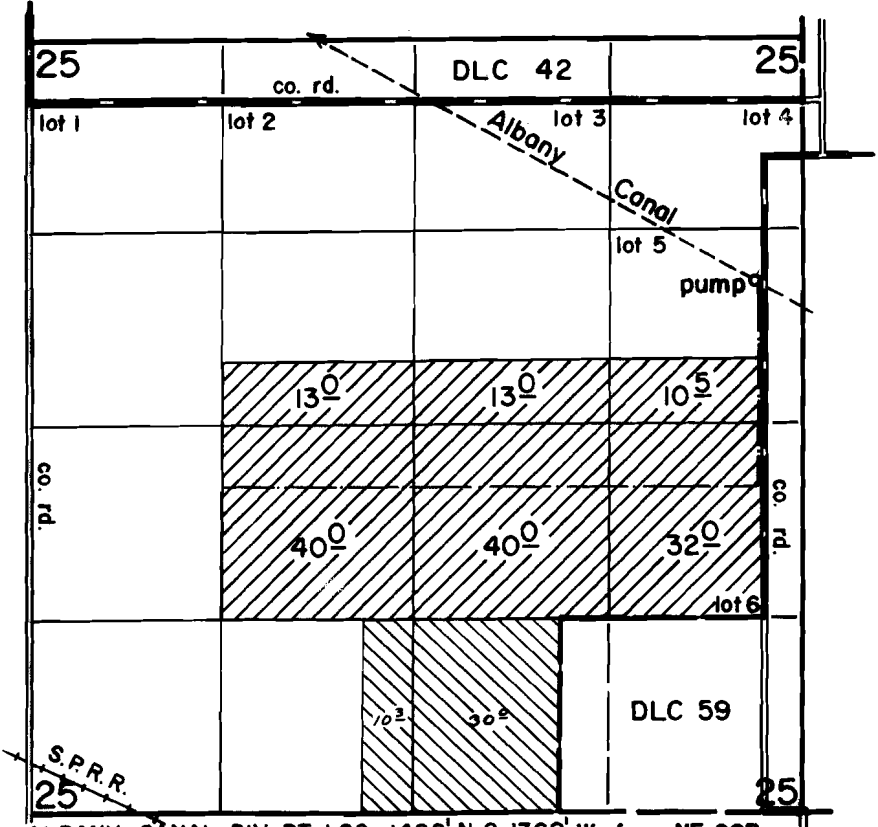

ALBANY CANAL DIV. PT. LOC: 1400' N & 1360' W. from NE COR
 CHEADLE DLC 38, sec. 19, T.12 S., R.1W., W.M.

FINAL PROOF SURVEY UNDER

Application No. 55894 52520 Permit No. 41922 39641 

IN NAME OF
INEZ G. GILBERT TRUST

Surveyed Sept. 8 1976, by D. Norby
 Aug. 6 1981 by L. TOLL