


T.5S.R.2W. W.M.

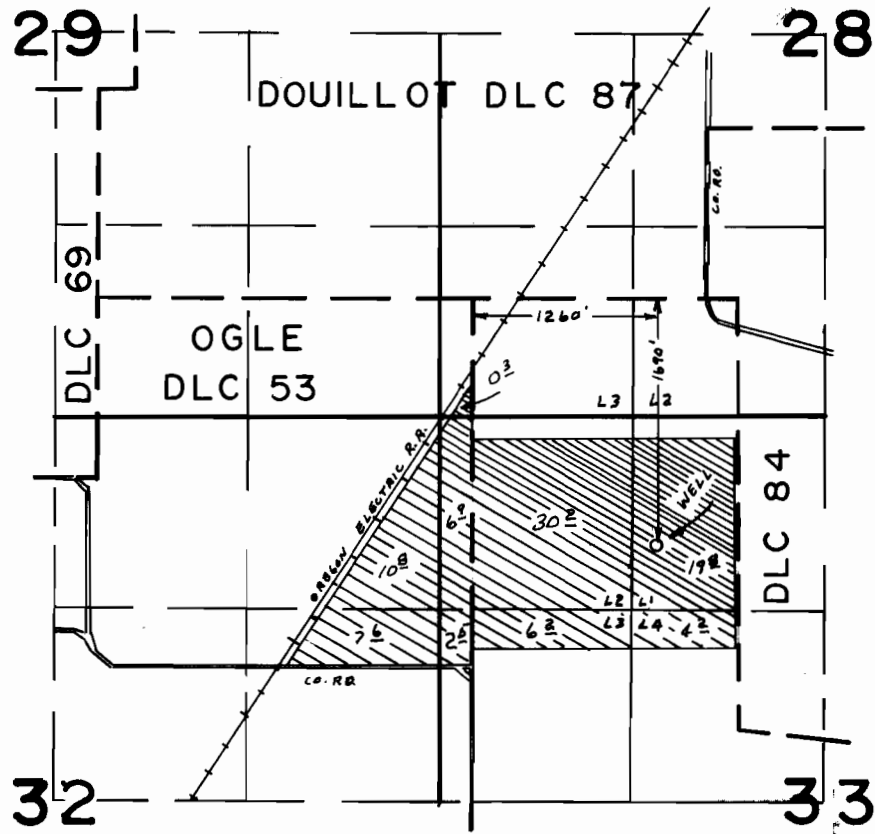

FINAL PROOF SURVEY UNDER

Application No. G-3814 Permit No. G-3245
IN NAME OF

DAVID AND ELDON DITCHEN

Surveyed SEP. 4 1974, by L.H. NUNN