


T.2N. R.2W. W.M.

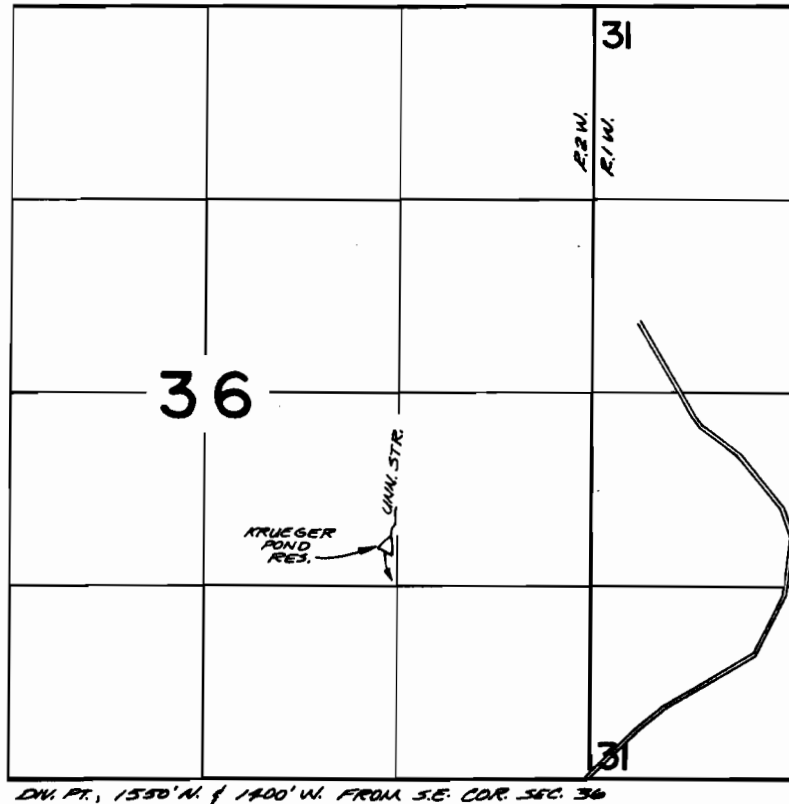

FINAL PROOF SURVEY
UNDER

R 44713 R 5284
Application No. 44714 Permit No. 33476
IN NAME OF

RAYMOND J. & LEONA J. KRUEGER

Surveyed JULY 10 1975, by RGMUCKEN