


T.7S. R.5W. W.M.

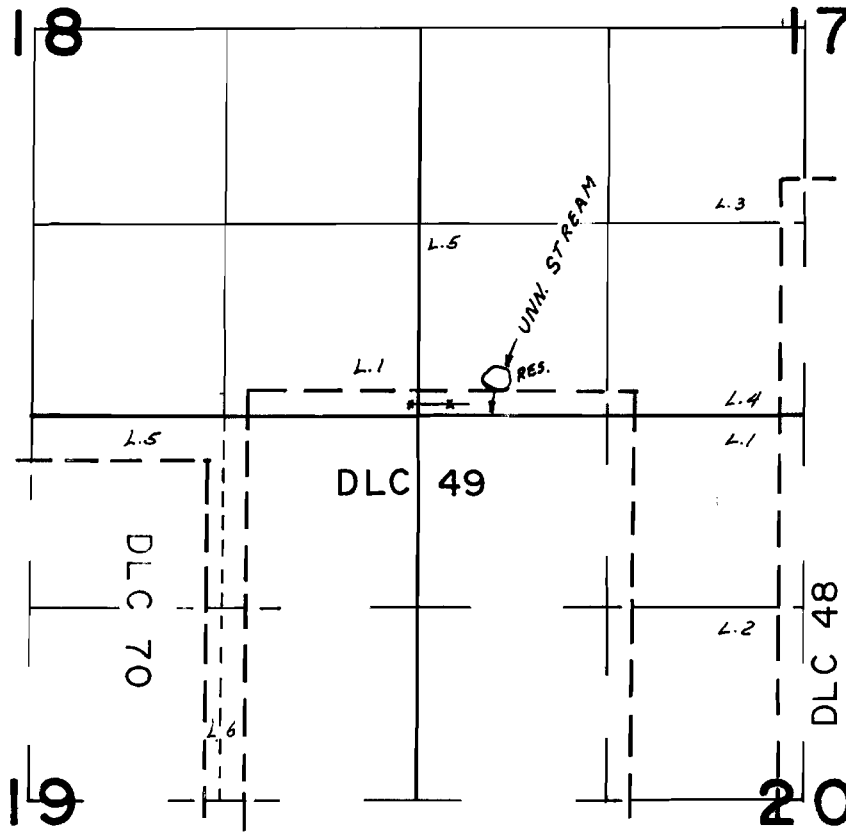

RES. LOC. 180' N. & 520' E. FROM SW COR. SEC. 17

FINAL PROOF SURVEY
UNDER

R-50258 R-6103
Application No. 50259 Permit No. 37707
IN NAME OF

HAROLD SWEET

Surveyed OCT. 14, 1975, by L.H. NUNN